

STATE ENGINEER  
Salem, Oregon

KLAM  
601  
KLAMATH  
Well Record

STATE WELL NO. 30/8-25E(1)  
COUNTY Klamath  
APPLICATION NO. G-1901

OWNER: C. C. Pinneo

MAILING

ADDRESS: 1436 McClellan Drive

LOCATION OF WELL: Owner's No. 1


CITY AND

STATE: Klamath Falls

SW 1/4 NW 1/4 Sec. 25 T. 30 S., R. 8 E. W.M.

Bearing and distance from section or subdivision

corner S. 1° 30' E. 1344 ft. from NW corner  
Sec. 25

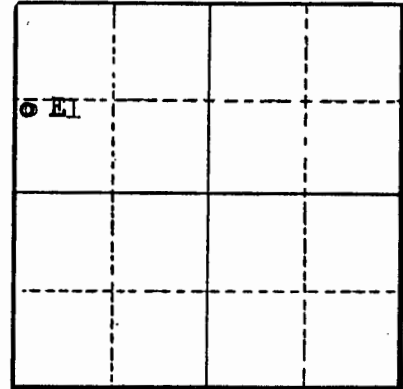

Section 25

Altitude at well

TYPE OF WELL: drilled Date Constructed

Depth drilled 312 Depth cased 312

CASING RECORD:

6-inch

FINISH:

AQUIFERS:

WATER LEVEL:  
flows

PUMPING EQUIPMENT: Type H.P.  
Capacity G.P.M.

WELL TESTS:

Drawdown ft. after hours G.P.M.

Drawdown ft. after hours G.P.M.

USE OF WATER irrigation Temp. °F., 19.

SOURCE OF INFORMATION

DRILLER or DIGGER

ADDITIONAL DATA:

Log Water Level Measurements Chemical Analysis Aquifer Test

REMARKS:

(USE ADDITIONAL SHEETS IF NECESSARY)