

STATE ENGINEER
Salem, Oregon

KLAM
603

KLAM 603
Well Record

STATE WELL NO. 30/8-25F (1)
COUNTY Klamath
APPLICATION NO. G-1901

OWNER: C. C. Pinneo

MAILING

ADDRESS: 1436 McClellan Drive

LOCATION OF WELL: Owner's No. 2


CITY AND

STATE: Klamath Falls

1/4 1/4 Sec. T. N. E.
S., R. W., W.M.

Bearing and distance from section or subdivision

corner S. 43° 19' E. 1937 ft. from NW corner
Sec. 25

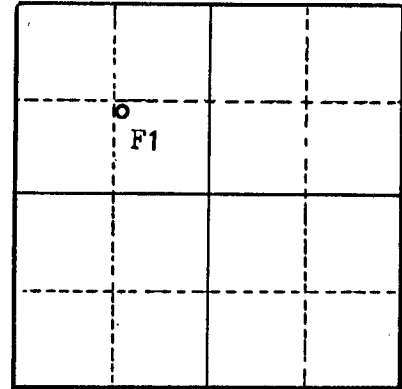

Section 25

Altitude at well

TYPE OF WELL: Drilled Date Constructed

Depth drilled 640 Depth cased 640

CASING RECORD:

6-inch

FINISH:

AQUIFERS:

WATER LEVEL:
flows

PUMPING EQUIPMENT: Type H.P.
Capacity G.P.M.

WELL TESTS:

Drawdown ft. after hours G.P.M.

Drawdown ft. after hours G.P.M.

USE OF WATER irrigation Temp. °F., 19

SOURCE OF INFORMATION

DRILLER or DIGGER

ADDITIONAL DATA:

Log Water Level Measurements Chemical Analysis Aquifer Test

REMARKS:

(USE ADDITIONAL SHEETS IF NECESSARY)