

ASHLEY Ladeena K * WRD

From: Rodney Erler <lic.driller@gmail.com>
Sent: Friday, March 8, 2024 4:01 PM
To: ASHLEY Ladeena K * WRD
Subject: Fwd: Walton well location

Rodney Erler

503-551-0245

Flow & Purity Tests

for Water Wells...

Oregon Well Drilling

License # 663

Begin forwarded message:

From: Keith Walton <knwalton619@gmail.com>
Date: March 8, 2024 at 9:52:34 AM PST
To: roderler@hotmail.com, lic.driller@gmail.com
Subject: Walton well location


Tax Lot 203 (was tax lot 202 when well was drilled. Subdivided, western half kept 202, ours assigned 203)

Approx. 110 ft. north -northeast of edge of Tumbo Drive at Gracies Road.

Location at mapping tool green flag, see Lat and Long.

Keith and Nancy Walton



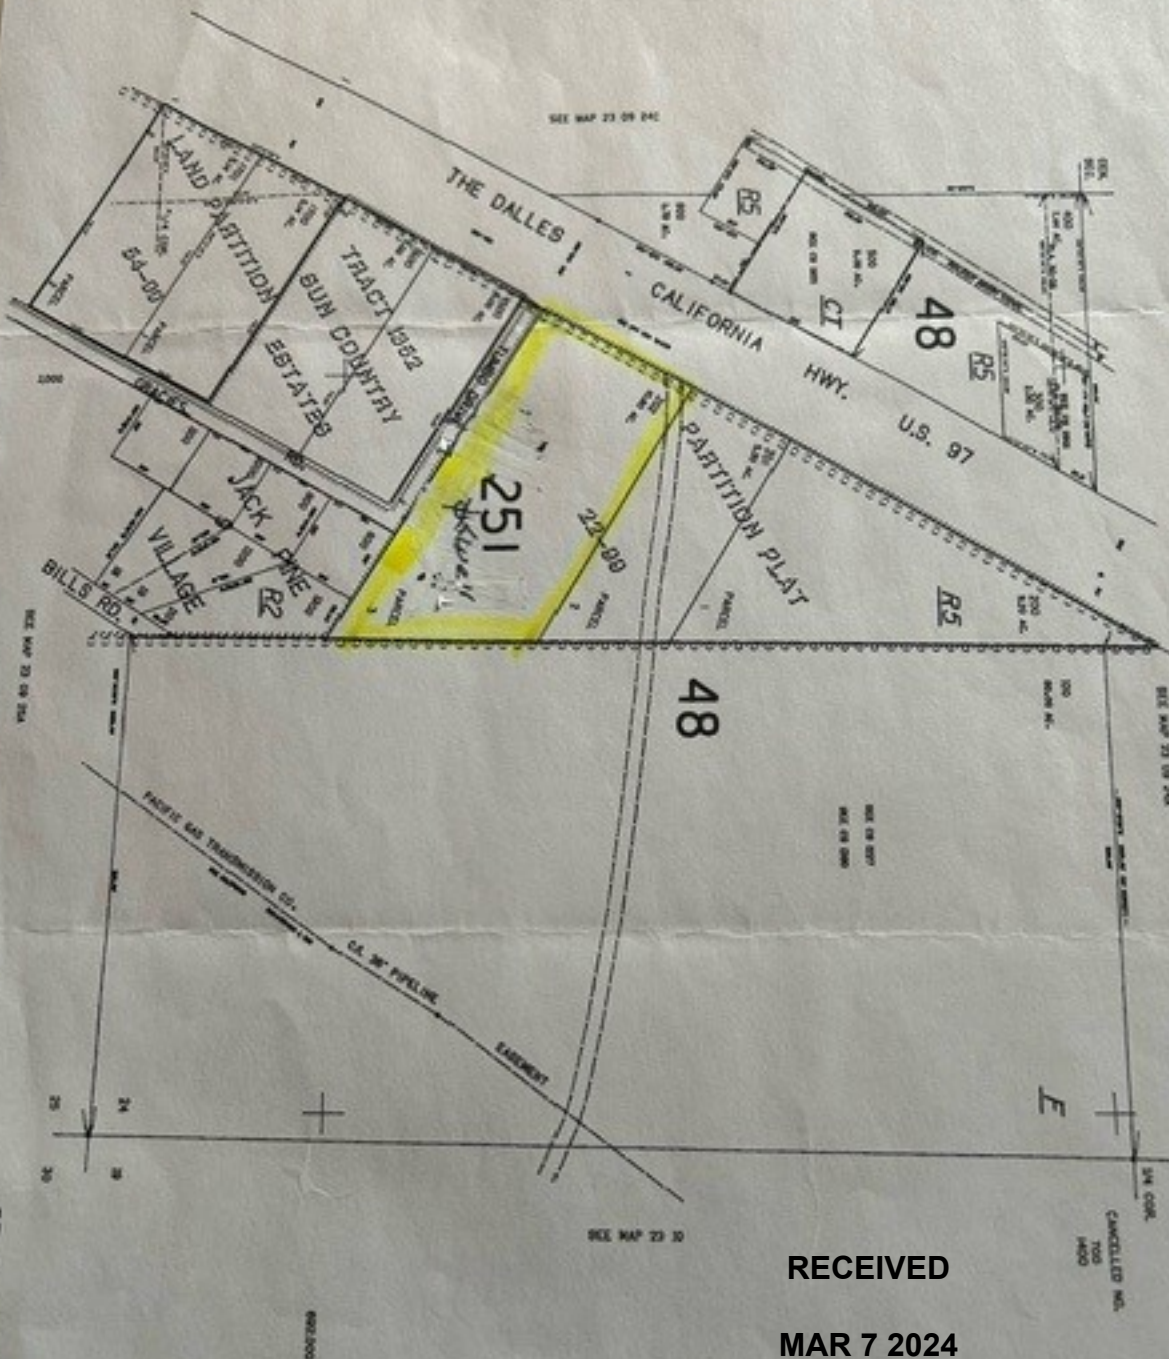

RECEIVED

MAR 7 2024

OWRD


23 09 24D

REVISED 07-23-14
THIS MAP WAS PREPARED FOR
ASSESSMENT PURPOSE ONLY

SE1/4 SEC. 24 T.23S. R.09E. WM.
KLAMATH COUNTY

23 09 24D

1"=200'

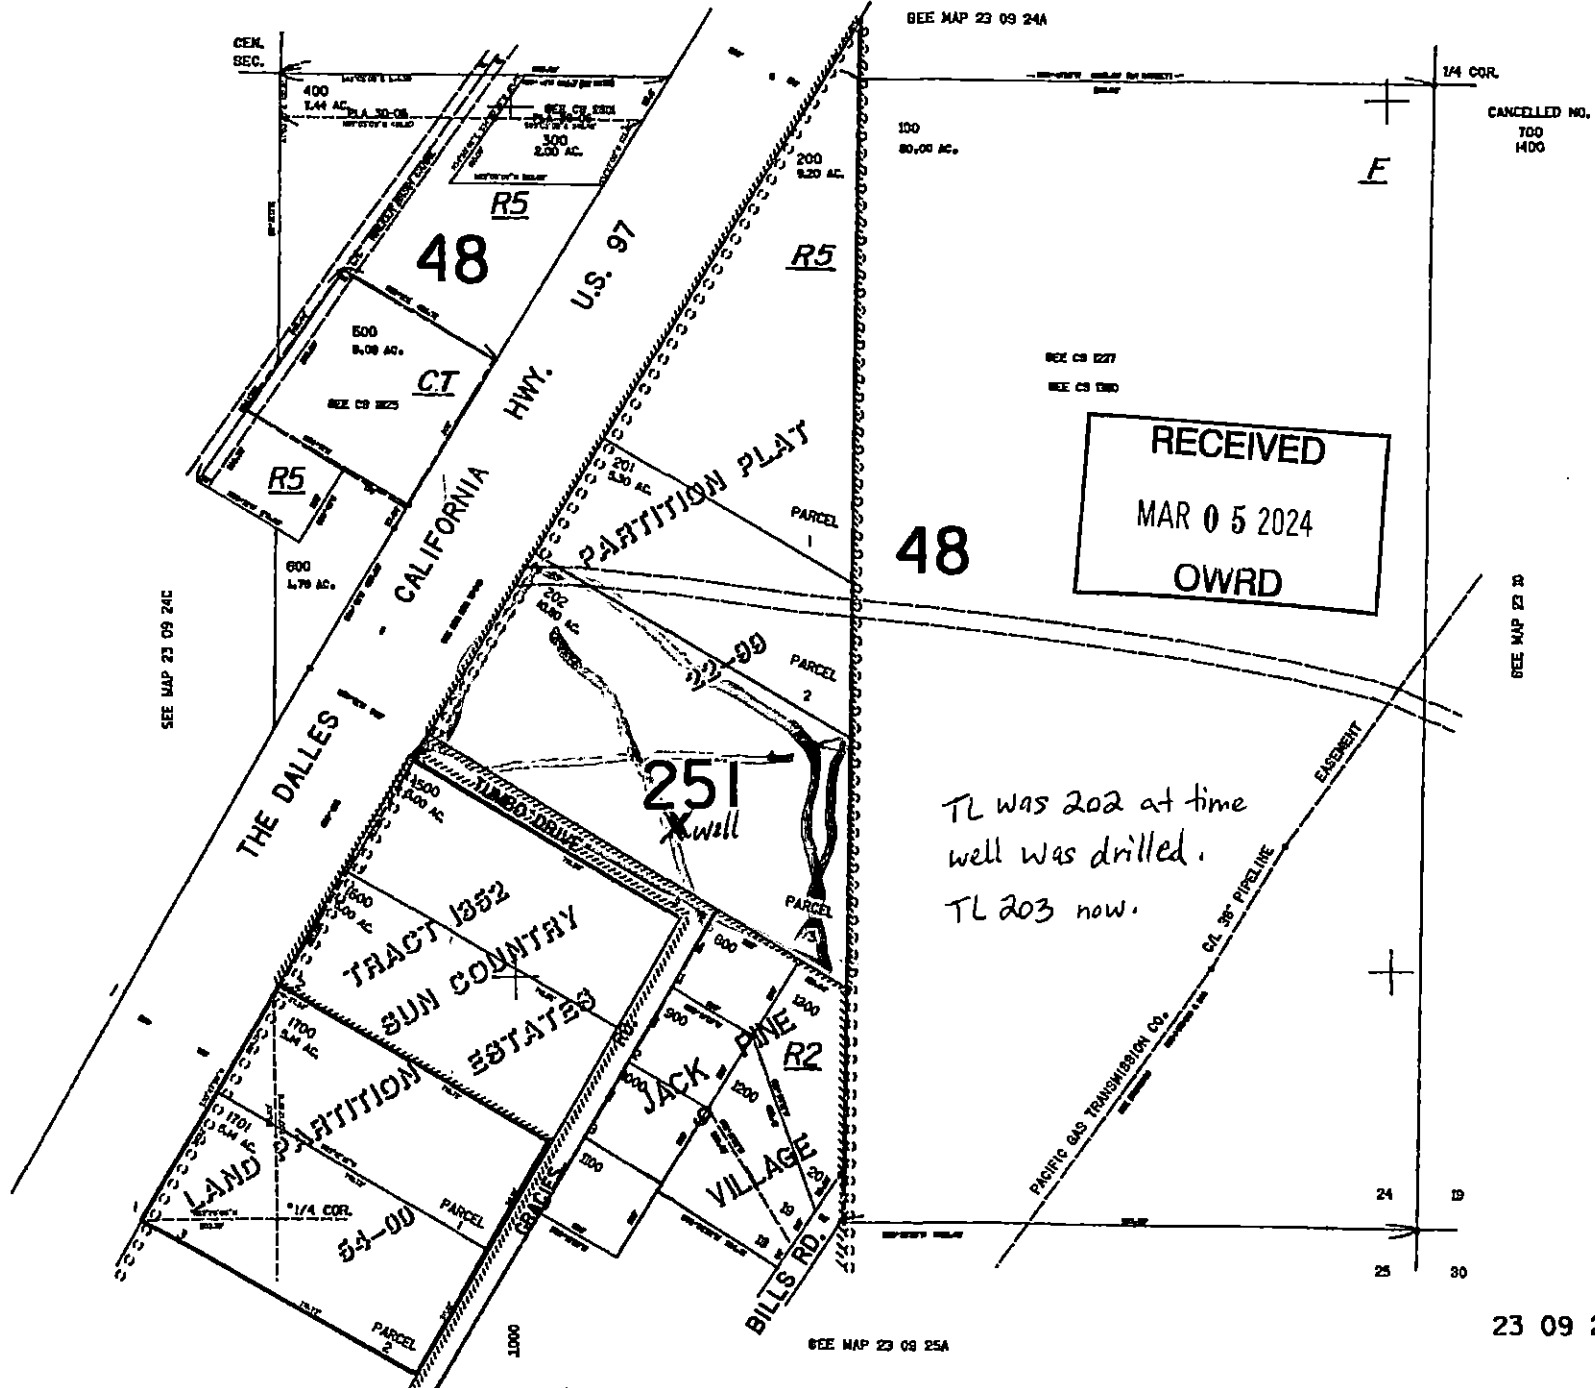

SEE MAP 23 09 25A

23 09 24D