STATE OF OREGON
WATER SUPPLY WELL REPORT
(as required by ORS 537.545 & 537.765 and OAR 690-205-0210)

KLAM 62424
7/13/2026

WELL I.D. LABEL# L 159710
START CARD # 1082005
ORIGINAL LOG #

(1) LAND OWNER

Owner Well I.D.
First Name Last Name
Company DOUBLE J FARMS
Address 13383 HARPOLD RD
City KLAMATH FALLS State OR Zip 97603

(2) TYPE OF WORK

[X] New Well [ ] Deepening [ ] Conversion
[ ] Alteration (complete 2a & 10) [ ] Abandonment(complete 5a)

(2a) PRE-ALTERATION

	Dia	+	From	To	Gauge	Stl	Plstc	Wld	Thrd
Casing:									

	Material	From	To	Amt	sacks/lbs
Seal:					

(3) DRILL METHOD

[X] Rotary Air [X] Rotary Mud [ ] Cable [ ] Auger
[ ] Reverse Rotary [ ] Other

(4) PROPOSED USE

[ ] Domestic [X] Irrigation [ ] Community
[ ] Industrial/ Commercial [ ] Livestock [ ] Dewatering
[ ] Thermal [ ] Injection [ ] Other

(5) BORE HOLE CONSTRUCTION

Special Standard [ ] (Attach copy)
Depth of Completed Well 628.00 ft.

BORE HOLE Dia	From	To	SEAL Material	From	To	Amt	sacks/lbs
20	0	260	Cement	0	260	230	S
15	260	531			Calculated	154.38	
12	531	628					
					Calculated		

Seal placement method: [ ] A [ ] B [X] C [ ] D [ ] E [ ] Other:
Backfill placed from ft. to ft. Material
Filter pack from ft. to ft. Material Size
Explosives used: [ ] Type Amount
Seal Placement Begin Date 5/8/2026 Begin Time 10 00

(5a) ABANDONMENT USING UNHYDRATED BENTONITE

Proposed Amount Actual Amount

(6) CASING/LINER

C/L	Dia	+	From	To	Gauge	Mat. Type	Wld	Thrd	Shoe	Shoe Location
C	16	X	1	220	0.250	ST	X			
C	16		220	260	0.375	ST	X			

Temp casing [ ] Yes Dia From + [ ] To

(7) PERFORATIONS/SCREENS

Perforations Method
Screens Type Material

Perf/ Screen	Casing/ Liner	Screen Dia	From	To	Scrn/slot width	Slot length	# of slots	Tele/ Pipe size

(8) WELL TESTS: Minimum testing time is 1 hour

Type of Test	Yield (gal/min)	Drawdown	Drill Stem/ Pump Depth	Duration (hr)
Air	1500		160	3

Temperature 72 °F Lab analysis [ ] Yes By
Water quality concerns? [ ] Yes (describe below) TDS amount 134 ppm

From	To	Description	Amount	Units

(9) LOCATION OF WELL (legal description)

County KLAMATH Twp 40.00 S N/S Range 11.00 E E/W WM
Sec 11 SE 1/4 of the NE 1/4 Tax Lot 102
Tax Map Number Lot
Lat ° ' " or 42.10621000 DMS or DD
Long ° ' " or -121.48311000 DMS or DD
( ) Street address of well (•) Nearest address
25442 SCHAUPP RD.

(10) STATIC WATER LEVEL

	Date	SWL(psi)	+	SWL(ft)
Existing Well / Pre-Alteration				
Completed Well	6/30/2026			64

Flowing Artesian? [ ] Dry Hole? [ ]

WATER BEARING ZONES Depth water was first found 531.00

SWL Date	From	To	Est Flow	SWL(psi)	+	SWL(ft)
6/30/2026	531	628	2000			64

(11) WELL LOG

Ground Elevation 4154.26 FT

Material	From	To
boulders and shale	0	4
brown clay	4	32
blue clay	32	531
broken fractured basalts	531	628

Construction
Begin Date 5/5/2026 Begin Time 10 00 End Date 6/30/2026

(unbonded) Water Well Constructor Certification

I certify that the work I performed on the construction, deepening, alteration, or abandonment of this well is in compliance with Oregon water supply well construction standards. Materials used and information reported above are true to the best of my knowledge and belief.

License Number Date

Signed

(bonded) Water Well Constructor Certification

I accept responsibility for the construction, deepening, alteration, or abandonment work performed on this well during the construction dates reported above. All work performed during this time is in compliance with Oregon water supply well construction standards. This report is true to the best of my knowledge and belief.

License Number 2101 Date 7/13/2026

Signed RYON FREEMAN (E-filed)
Drilling Company: TW Well Services LLC.

WATER SUPPLY WELL REPORT - continuation page

KLAM 62424

7/13/2026

WELL I.D. LABEL# L 159710
START CARD # 1082005
ORIGINAL LOG #

(2a) PRE-ALTERATION

Dia	+	From	To	Gauge	Stl	Plstc	Wld	Thrd

Material	From	To	Amt	sacks/lbs

(5) BORE HOLE CONSTRUCTION

BORE HOLE Dia	From	To	SEAL Material	From	To	Amt	sacks/lbs
					Calculated		
					Calculated		
					Calculated		
					Calculated		

FILTER PACK

From	To	Material	Size

(6) CASING/LINER

C/L	Dia	+	From	To	Gauge	Mat. Type	Wld	Thrd	Shoe	Shoe Location

(7) PERFORATIONS/SCREENS

Perf/ Screen	Casing/ Liner	Screen Dia	From	To	Scrn/slot width	Slot length	# of slots	Tele/ Pipe size

(8) WELL TESTS: Minimum testing time is 1 hour

Type of Test	Yield (gal/min)	Drawdown	Drill Stem/ Pump Depth	Duration (hr)

Water Quality Concerns

From	To	Description	Amount	Units

(10) STATIC WATER LEVEL

SWL Date	From	To	Est Flow	SWL(psi)	+	SWL(ft)

(11) WELL LOG

Material	From	To

WATER SUPPLY WELL REPORT - Map with location identified must be attached and shall include an approximate scale and north arrow

KLAM 62424

7/13/2026

Map of Hole

STATE OF OREGON
WELL LOCATION MAP

This map is supplemental to the WATER SUPPLY WELL REPORT

Oregon Water Resources Department
725 Summer St NE, Salem OR 97301
(503)986-0900

LOCATION OF WELL

Latitude: 42.10621000 Datum: WGS84
Longitude: -121.48311000
Township/Range/Section/Quarter-Quarter Section:
WM40.00S11.00E11SENE
Address of Well:
25442 SCHAUPP RD.

Well Label: 159710

Printed: July 13, 2026

DISCLAIMER: This map is intended to represent the approximate location the well. It is not intended to be construed as survey accurate in any manner.
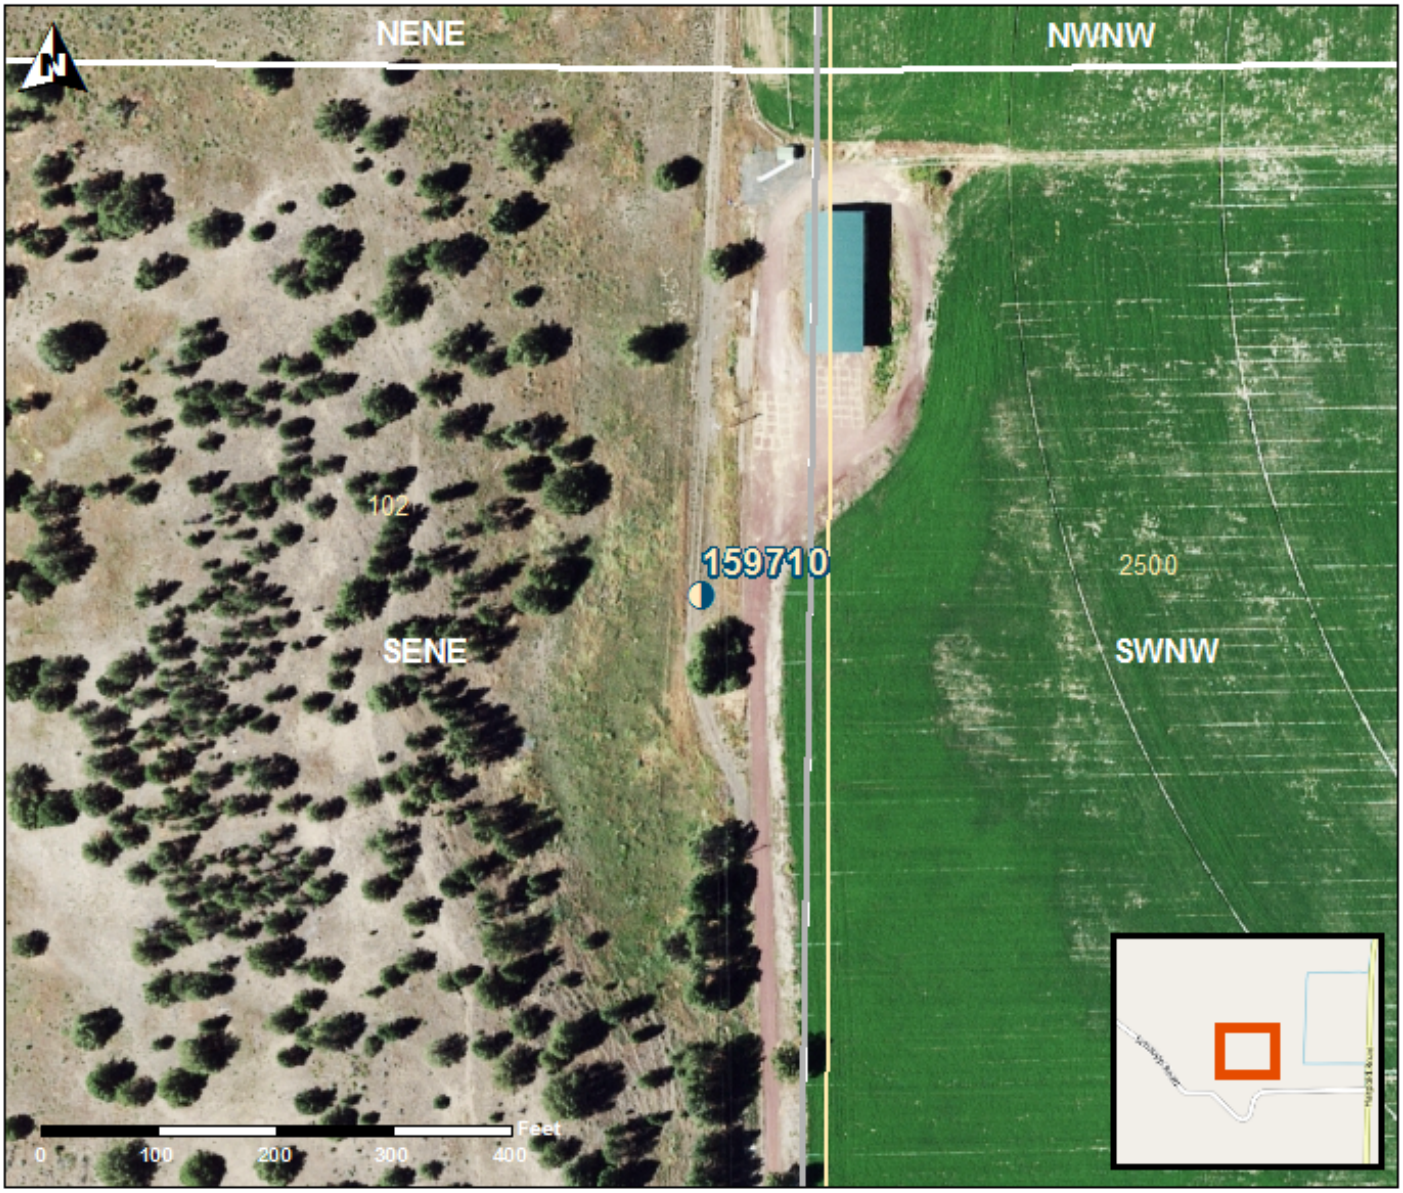
Provided by well constructor