

*Klam  
662*

# Well Record

OWNER: J. Ball MAILING ADDRESS: \_\_\_\_\_

LOCATION OF WELL: Owner's No. \_\_\_\_\_ CITY AND STATE: \_\_\_\_\_


..... $\frac{1}{4}$ ..... $\frac{1}{4}$  Sec. .... T. .... N. E.  
..... S., R. .... W., W.M.

Bearing and distance from section or subdivision corner \_\_\_\_\_

Altitude at well 4,560

TYPE OF WELL: Drilled Date Constructed \_\_\_\_\_

Depth drilled 61 Depth cased 54

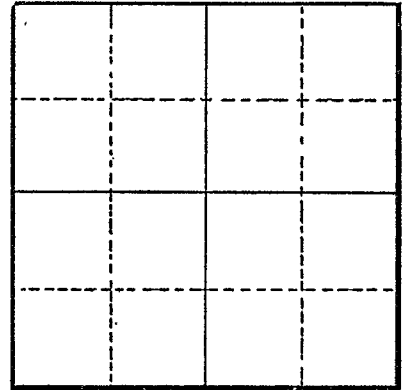

Section \_\_\_\_\_

### CASING RECORD:

10 inch

### FINISH:

### AQUIFERS:

Pumice sand from 48 to 61

### WATER LEVEL:

25 feet below land surface on 7/23/53

PUMPING EQUIPMENT: Type Jet H.P. \_\_\_\_\_  
Capacity 20 G.P.M.

### WELL TESTS:

Drawdown ..... ft. after ..... hours ..... G.P.M.  
Drawdown ..... ft. after ..... hours ..... G.P.M.

USE OF WATER Domestic Temp. .... °F. ...., 19....

SOURCE OF INFORMATION USGS

DRILLER or DIGGER \_\_\_\_\_

### ADDITIONAL DATA:

Log X Water Level Measurements ..... Chemical Analysis X Aquifer Test .....

### REMARKS:

Supplies service station



STATE ENGINEER  
Salem, Oregon

State Well No. 3117-24C

County Klamath

Application No. ....

### Chemical Analysis

OWNER J. Ball ..... OWNER'S NO. ....

ANALYST U.S. Geological Survey Address .....

Date of Collection 2-19-55 .....

Point of Collection .....

	P.P.M.	E.P.M.
Silica (SiO <sub>2</sub> )	39.	
Iron (Fe) Total	.48	
Manganese (Mn)		
Calcium (Ca)	3.8	
Magnesium (Mg)	3.0	
Sodium (Na)	16.	
Potassium (K)	1.8	
Bicarbonate (HCO <sub>3</sub> )	70.	
Carbonate (CO <sub>3</sub> )		
Sulfate (SO <sub>4</sub> )	.3	
Chloride (Cl)	.8	
Fluoride (F)	.2	
Nitrate (NO <sub>3</sub> )	.0	
Boron (B)	.04	
Dissolved Solids	83.	
Hardness as CaCO <sub>3</sub>	22.	
Specific Conductance (Micromhos at 25°C)	112.	
pH	7.5	
Percent Sodium	59.	
Sodium Absorption Ratio (S.A.R.)	1.5	
CLASS		