

*Klamath
745*

Well Record

OWNER: Wood River Motel MAILING ADDRESS:

LOCATION OF WELL: Owner's No. CITY AND STATE:


..... $\frac{1}{4}$ $\frac{1}{4}$ Sec. T. N. E.
S., R. W., W.M.

Bearing and distance from section or subdivision corner

Altitude at well 4,170

TYPE OF WELL: Drilled Date Constructed

Depth drilled Depth cased

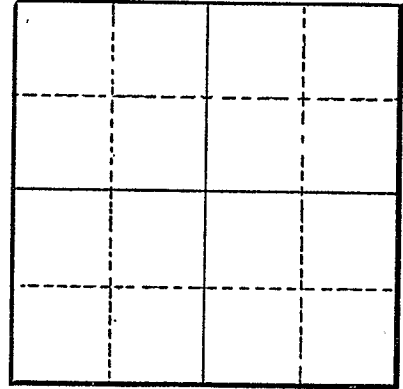

Section

CASING RECORD:

2 inch

FINISH:

AQUIFERS:

Sand

WATER LEVEL:

+19.75 feet below land surface on 12/18/54

PUMPING EQUIPMENT: Type None H.P.
Capacity G.P.M.

WELL TESTS:

Drawdown ft. after hours G.P.M.

Drawdown ft. after hours G.P.M.

USE OF WATER Domestic Temp. °F., 19.....

SOURCE OF INFORMATION USGS

DRILLER or DIGGER

ADDITIONAL DATA:

Log Water Level Measurements Chemical Analysis Aquifer Test

REMARKS:

Supplies motel.