

*Klamath
770*


Well Record

OWNER: Paul Wampler MAILING ADDRESS: _____

LOCATION OF WELL: Owner's No. _____ CITY AND STATE: _____

..... ¼ ¼ Sec. T. N. E.
..... S., R. W., W.M.

Bearing and distance from section or subdivision
corner _____

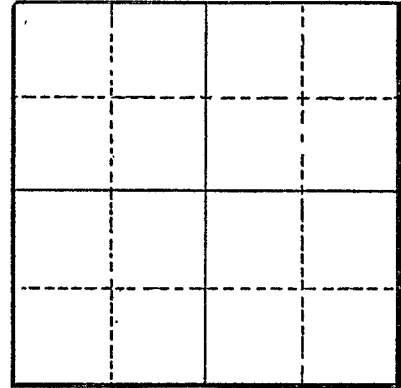

Section _____

Altitude at well 4.145

TYPE OF WELL: Drilled Date Constructed _____

Depth drilled 90.5 Depth cased 85

CASING RECORD:

6 inch

FINISH:

AQUIFERS:

Sand

WATER LEVEL:

Flowing well--11/20/54

PUMPING EQUIPMENT: Type None H.P. _____
Capacity _____ G.P.M.

WELL TESTS:

Drawdown ft. after hours G.P.M.

Drawdown ft. after hours G.P.M.

USE OF WATER Stock Temp. °F., 19.....

SOURCE OF INFORMATION USGS

DRILLER or DIGGER _____

ADDITIONAL DATA:

Log Water Level Measurements Chemical Analysis Aquifer Test

REMARKS:

Flows about 100 gpm; a 2-inch well 50 ft. to the north flows about 20 gpm.