

*Klamath  
931*

# Well Record

STATE WELL NO. 34/7-30A1  
COUNTY Klamath  
APPLICATION NO. \_\_\_\_\_

OWNER: R. P. Robinson


MAILING ADDRESS: \_\_\_\_\_

LOCATION OF WELL: Owner's No. \_\_\_\_\_

CITY AND STATE: \_\_\_\_\_

..... 1/4 ..... 1/4 Sec. .... T. .... N. E.  
S., R. .... W., W.M.

Bearing and distance from section or subdivision corner \_\_\_\_\_

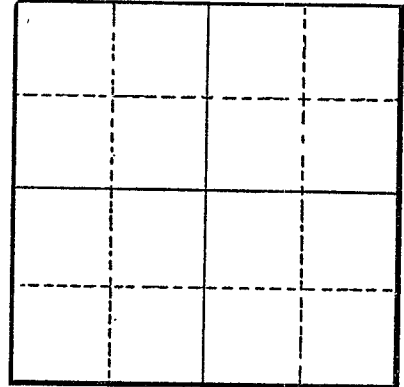

Section \_\_\_\_\_

Altitude at well 4,175

TYPE OF WELL: Drilled Date Constructed \_\_\_\_\_

Depth drilled 24.0 Depth cased \_\_\_\_\_

CASING RECORD:

6 inch

FINISH:

AQUIFERS:

Gravel and sand from 32 to 35

WATER LEVEL:

4.56 feet below land surface on 11/20/54

PUMPING EQUIPMENT: Type Centrifugal  
Capacity 5 G.P.M. H.P. \_\_\_\_\_

WELL TESTS:

Drawdown ..... ft. after ..... hours ..... G.P.M.  
Drawdown ..... ft. after ..... hours ..... G.P.M.

USE OF WATER Stock Temp. ..... °F. ...., 19.....

SOURCE OF INFORMATION USGS

DRILLER or DIGGER \_\_\_\_\_

ADDITIONAL DATA:

Log ..... Water Level Measurements ..... Chemical Analysis ..... Aquifer Test .....

REMARKS:

Penetrated 6 ft. of soil, 4 ft. loose boulders and sand, and 22 ft. basalt boulders above aquifer.