

STATE ENGINEER
Salem, Oregon

lake 1060

Well Record


STATE WELL NO. 27/17-27J
COUNTY Lake
APPLICATION NO. G-2282

OWNER: Wahl - Century Ranch MAILING ADDRESS: _____

LOCATION OF WELL: Owner's No. 3 CITY AND STATE: Fort Rock, Oregon

NW $\frac{1}{4}$ SE $\frac{1}{4}$ Sec. 27 T. 27 N. S., R. 17 E. W., W.M.

Bearing and distance from section or subdivision corner _____

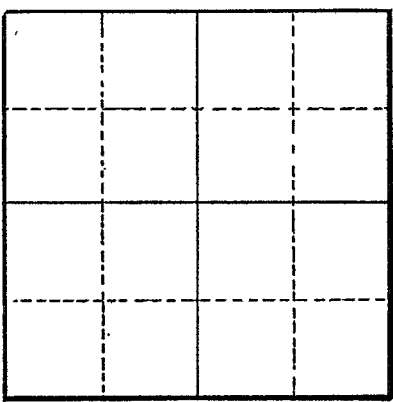

Section 27

Altitude at well _____

TYPE OF WELL: drilled Date Constructed _____

Depth drilled 240 Depth cased 25

CASING RECORD: 20 inch

FINISH: _____

AQUIFERS: _____

WATER LEVEL: 56.38 ft. below land surface

PUMPING EQUIPMENT: Type _____ H.P. _____
Capacity _____ G.P.M.

WELL TESTS:
Drawdown _____ ft. after _____ hours _____ G.P.M.
Drawdown _____ ft. after _____ hours _____ G.P.M.

USE OF WATER irrigation Temp. _____ °F., 19 _____

SOURCE OF INFORMATION _____

DRILLER or DIGGER _____

ADDITIONAL DATA:
Log _____ Water Level Measurements _____ Chemical Analysis _____ Aquifer Test _____

REMARKS: _____

