

STATE ENGINEER
Salem, Oregon

LAKE 1405
OBSERVATION WELL
Well Record

STATE WELL NO. 28/16-19C(1)
COUNTY Lake
APPLICATION NO. U-656

OWNER: A. E. Albertsen

MAILING

ADDRESS:


LOCATION OF WELL: Owner's No. 1

CITY AND

STATE:

NE $\frac{1}{4}$ NW $\frac{1}{4}$ Sec. 19 T. 28 S., R. 16 W., W.M.

Bearing and distance from section or subdivision
corner S. 84° 18' W. 471 ft. from N $\frac{1}{4}$ cor. Sec. 19

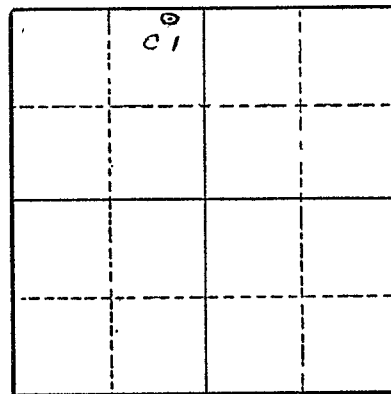

Section 19

Altitude at well

TYPE OF WELL: drilled Date Constructed 1953

Depth drilled 411 Depth cased

CASING RECORD: 16 inch

FINISH:

AQUIFERS:

WATER LEVEL: 41 ft. on 12-7-53

PUMPING EQUIPMENT: Type H.P.
Capacity G.P.M.

WELL TESTS:

Drawdown ft. after hours G.P.M.

Drawdown ft. after hours G.P.M.

USE OF WATER irrigation Temp. °F., 19

SOURCE OF INFORMATION

DRILLER or DIGGER

ADDITIONAL DATA:

Log ☒ Water Level Measurements Chemical Analysis Aquifer Test

REMARKS:

LAKE 1405

STATE ENGINEER
Salem, Oregon

State-Well No. 28/16-19C(1)
County _____ Lake _____
Application No. U-656

Well Log

Owner: A. E. Albertson Owner's No.

Driller: Pat McGinley Date Drilled

[illegible]

STATE ENGINEER
Salem, Oregon

County LAKE

Application No. U-656

OWNER: A. E. Albertson OWNER'S NO.

Description of measuring point: Top of port on East side of Pump base at LSD

[illegible]

REMARKS: _____

LAKE 1405

Oregon Water Resources Department
725 Summer Street NE, Suite A
Salem Oregon 97301
(503) 986-0900
www.wrd.state.or.us

Application for Well ID Number

RECEIVED**MAY 11 2016**

Do not complete if the well already has a Well Identification Number.

I. OWNER INFORMATION

WATER RESOURCES DEPT
SALEM, OREGON

Current Owner Name (please print): ZX Ranch

Mailing Address: PO Box 7

City, State, Zip: Paisley, OR 97636

Mail Well ID Tag to: ☒ SAME AS ABOVE ☐ In Care Of (C/O)

Name & Address: _____

City, State, Zip: _____

II. WELL LOCATION INFORMATION (Please fill out as completely as possible)

Township: 28 (North South) Range: 16 (East) / West Section: 19 NE 1/4 of the NW 1/4

Tax Lot (usually last 3-5 numbers of Tax Map #): 1700 County LAKE

GPS Coordinates: 43.13645 -120.87143

Street Address of Well, City: SILVER LAKE, OREGON

If the property had a different street address in the past: _____

III. GENERAL WELL INFORMATION (Please fill out as completely as possible, AND attach copy of Well Log, if available)

Use of Well (domestic, irrigation, commercial, industrial, monitoring): IRRIGATION

Date Well Constructed (or property built): 1953 Total Well Depth: 411' Casing Diameter: 18

Owner at time the well was constructed (if known): A.E. ALBERTSEN Well Log # (if known): LAKE 1405

Other Information: _____

SUBMITTED BY (please print): DAPHNE STORY

PHONE: 541-943-3105

EMAIL &/or FAX: daphne.story@simplot.com

Send application to: Oregon Water Resources Department 725 Summer St NE, Suite A, Salem, Oregon 97301; or fax to (503) 986-0902.
Applications are processed in the order they are received, and Well ID Numbers are mailed within 4-5 business days.

For Official Use Only by the Oregon Water Resources Department:

Received Date:

5-11-16

Well Log Number:

LAKE 1405

Well Identification #:

L-122913