

STATE ENGINEER
Salem, Oregon

Well Record

STATE WELL NO. 29/16-15D(1)
COUNTY Lake
APPLICATION NO. G-4526
" " G-4526

OWNER: Tim Guinness

MAILING
ADDRESS:
CITY AND
STATE:

LOCATION OF WELL: Owner's No.

NW 1/4 NW 1/4 Sec. 15 T. 29 S., R. 16 E., W.M.


Bearing and distance from section or subdivision
corner

Altitude at well 4369

TYPE OF WELL: drilled Date Constructed 1949

Depth drilled 680 Depth cased 10

CASING RECORD: 6 inch

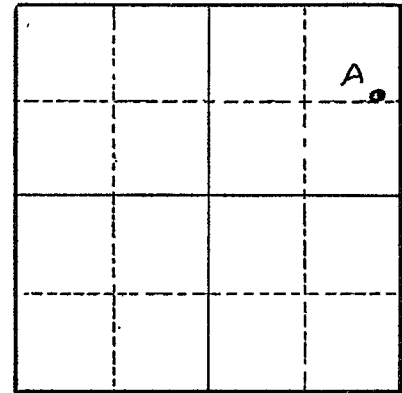

Section 16

FINISH:

AQUIFERS: Sand, fine black

WATER LEVEL: 72.41

PUMPING EQUIPMENT: Type none H.P.
Capacity G.P.M.

WELL TESTS:
Drawdown ft. after hours G.P.M.
Drawdown ft. after hours G.P.M.

USE OF WATER stock Temp. °F., 19

SOURCE OF INFORMATION

DRILLER or DIGGER

ADDITIONAL DATA:

Log X Water Level Measurements Chemical Analysis Aquifer Test

REMARKS: Hardness 35 ppm, Chloride 3 ppm

State Well No. 29/16-15D(1)
County _____ Lake _____
Application No. _____

Owner: Tim Guinee Owner's No.

Driller: Pat McGinley Date Drilled 1949

[illegible]