

STATE ENGINEER
Salem, Oregon

LAKE 1447

Well Record

STATE WELL NO. 29/17-23R(1)
COUNTY Lake
APPLICATION NO. U-11

OWNER: Desdamea Wixon

MAILING
ADDRESS:

LOCATION OF WELL: Owner's No.

CITY AND
STATE:

Summer Lake

SE 1/4 SE 1/4 Sec. 23 T. 29 N. S. R. 17 E. W., W.M.


Bearing and distance from section or subdivision

corner

Altitude at well 4314 USGS Report

TYPE OF WELL: drilled Date Constructed 1929

Depth drilled 352 Depth cased

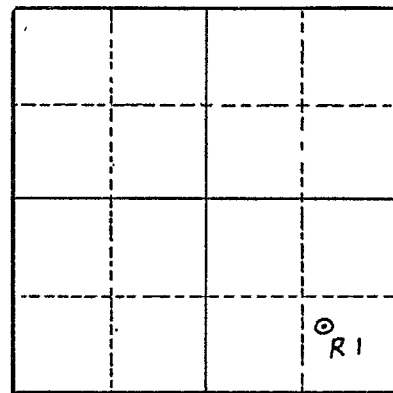

Section 23

CASING RECORD: 8 inch

FINISH:

AQUIFERS: Gravel, 345 to 352 ft.

WATER LEVEL:

PUMPING EQUIPMENT: Type H.P.
Capacity G.P.M.

WELL TESTS:

Drawdown ft. after hours G.P.M.

Drawdown ft. after hours G.P.M.

USE OF WATER Irrigation Temp. 54 °F. 11-29, 1949

SOURCE OF INFORMATION U-11 USGS Report, page 86

DRILLER or DIGGER C. E. Williams

ADDITIONAL DATA:

Log Water Level Measurements Chemical Analysis Aquifer Test

REMARKS: Hardness 20, chloride 3
Flowing about 1000 gpm (estimated)

STATE ENGINEER
Salem, Oregon

State Well No. 29/17-23R(1)
County Lake
Application No. U-11

Owner: Desdamona Wixon Owner's No. _____

Driller: C. E. Williams Date Drilled 1929

[illegible]



Oregon Water Resources Department
725 Summer Street NE, Suite A
Salem Oregon 97301
(503) 986-0900
www.wrd.state.or.us

Application for Well ID Number

Do not complete if the well already has a Well Identification Number.

I. OWNER INFORMATION

Current Owner Name (please print): STEVE C. SCOTT
Mailing Address: 62526 Erickson RD
City, State, Zip: Beard, Ore 97701
Mail Well ID Tag to: ☒ SAME AS ABOVE ☐ In Care Of (C/O)
Name & Address: _____
City, State, Zip: _____

II. WELL LOCATION INFORMATION (Please fill out as completely as possible)

Township: 29S (North South) Range: R 17 (East West) Section: 23
Tax Lot: 700 County Lake SE 1/4 SE 1/4
GPS Coordinates: 1220 ft N AND 1190 ft. W. from SE corner sec. 23
Street Address of Well, City: Summerlake, Oregon 50705 Shuffield Rd 97640 ^{ZIP}
If the property had a different street address in the past: _____

III. GENERAL WELL INFORMATION (Please fill out as completely as possible)

Use of Well (domestic, irrigation, commercial, industrial, monitoring): Fish Rearing; Wildlife HABITAT
Date Well Constructed (or property built): 1929 Total Well Depth: 352' Casing Diameter: 8"
Owner at time the well was constructed (if known): WIXON
Other Information: well # LAKE 1447

SUBMITTED BY (please print): STEVE SCOTT
PHONE: 541-419-1932 EMAIL &/or FAX: Sureshotscott3006@gmail.com

Send application to: Oregon Water Resources Department 725 Summer St NE, Suite A, Salem, Oregon 97301; or fax to (503) 986-0902. Applications are processed in the order they are received, and Well ID Numbers are mailed within 4-5 business days.

For Official Use Only by the Oregon Water Resources Department:

Received Date:

1-11-16

Well Log Number:

LAKE 1447

Well Identification #:

L-121022

RECEIVED BY OWRD