

STATE ENGINEER
Salem, Oregon

Well Record

STATE WELL NO. 29/17-32G(1)
COUNTY Lake
APPLICATION NO.

OWNER: Carl Klippel

MAILING
ADDRESS:
CITY AND
STATE:

LOCATION OF WELL: Owner's No.

SW 1/4 NE 1/4 Sec. 32 T. 29 N. S. R. 17 E. W., W.M.

Bearing and distance from section or subdivision


corner

Altitude at well 4295

TYPE OF WELL: drilled Date Constructed

Depth drilled 236.4 Depth cased

CASING RECORD: 8 inch

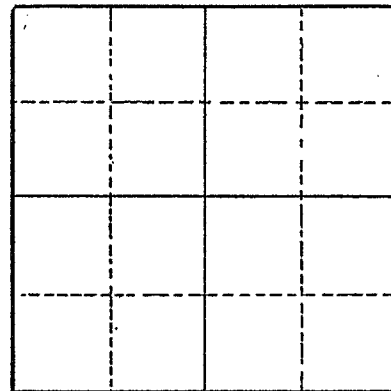

Section

FINISH:

AQUIFERS: sand

WATER LEVEL: flowing

PUMPING EQUIPMENT: Type none H.P.
Capacity G.P.M.

WELL TESTS:

Drawdown ft. after hours G.P.M.

Drawdown ft. after hours G.P.M.

USE OF WATER stock, irrigation Temp. 63 °F., 19

SOURCE OF INFORMATION

DRILLER or DIGGER

ADDITIONAL DATA:

Log Water Level Measurements Chemical Analysis Aquifer Test

REMARKS: Hardness 8 ppm, Chloride 6 ppm

Well reported to have entered rock; flow estimated at 50 to 100 gpm in 1940 at 120 in 1949.