

STATE ENGINEER
Salem, Oregon

Lake 1469
LAKE 1469 Well Record

WELL NO. 29/18-31F(1)
COUNTY Lake
APPLICATION NO. _____

OWNER: Perry Saddoris

MAILING
ADDRESS: _____

LOCATION OF WELL: Owner's No. _____

CITY AND
STATE: _____

SE $\frac{1}{4}$ NW $\frac{1}{4}$ Sec. 31 T. 29 S., R. 18 N. W., W.M.

Bearing and distance from section or subdivision


corner _____

Altitude at well 4270

TYPE OF WELL: drilled Date Constructed _____

Depth drilled 334.5 Depth cased _____

CASING RECORD: 8 inch

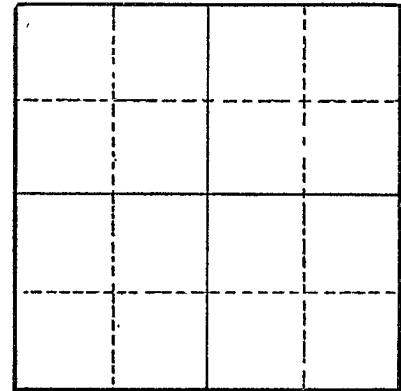

Section _____

FINISH: _____

AQUIFERS: _____

WATER LEVEL: flowing

PUMPING EQUIPMENT: Type none H.P. _____
Capacity _____ G.P.M.

WELL TESTS:

Drawdown _____ ft. after _____ hours _____ G.P.M.

Drawdown _____ ft. after _____ hours _____ G.P.M.

USE OF WATER stock, irrigation Temp. 59 °F. _____, 19____

SOURCE OF INFORMATION _____

DRILLER or DIGGER _____

ADDITIONAL DATA:

Log _____ Water Level Measurements _____ Chemical Analysis _____ Aquifer Test _____

REMARKS: Hardness 10 ppm, chloride 8 ppm
Estimated flow, 400 gpm

**Oregon Water Resources Department LAKE 1464**

725 Summer Street NE, Suite A

Salem Oregon 97301

(503) 986-0900

www.wrd.state.or.us

**Application for
Well ID Number*****Do not complete if the well already has a Well I.D Number.*****I. OWNER INFORMATION**Current Owner Name (please print): Ernest Duane & Dixie Rae Shuffield / Chaylon Duane & Amber Lee ShuffieldMailing Address: P.O. Box 85City: Summer Lake State: Oregon Zip: 97640Mailing Address (to send Well I.D.): P.O. Box 85City: Summer Lake State: Oregon Zip: 97640**II. WELL INFORMATION** (Do not complete this section if the well report is attached.)

Township: _____ (North/South) Range: _____ (East/West) Section: _____

Tax Lot: _____ County: _____ 1/4 _____ 1/4

Street Address of Well: _____ City: _____

Owner at time the well was constructed, (if known): _____

If the property had a different street address in the past: _____

III. GENERAL WELL INFORMATION (Do not complete this section if the well report is attached)

Use of Well (domestic, irrigation, commercial, industrial, monitoring): _____

Date Well Constructed: _____ Total Well Depth: _____ Casing Diameter: _____

Other Information: _____

SUBMITTED BY (please print): Chaylon Duane ShuffieldPHONE: 541.207.2310 FAX: N/A

Send application to Oregon Water Resources Department; 725 Summer St NE, Suite A; Salem, Oregon 97301-1266; fax (503) 986-0902. Applications are processed and Well I.D. Numbers are mailed every Wednesday.

For Official Use Only by the Oregon Water Resources Department:

Received Date:

1/16/12 - email

Well Log Number:

LAKE 1464

Well Identification #:

L-108368