

STATE ENGINEER
Salem, Oregon

Well Record

STATE WELL NO. 30/16-1R(2)
COUNTY Lake
APPLICATION NO. G-72
G-11199

OWNER: V. A. Withers

MAILING
ADDRESS:

LOCATION OF WELL: Owner's No. 2

CITY AND

STATE: Paisley, Oregon

SE 1/4 SE 1/4 Sec. 1 T. 30 N. S., R. 16 E. W., W.M.

Bearing and distance from section or subdivision


corner N. 47° 31' W. 1655 ft. from SE cor. Sec. 1

Altitude at well

TYPE OF WELL: drilled Date Constructed

Depth drilled 222 Depth cased 140

CASING RECORD: 8 inch, set to 140 ft.

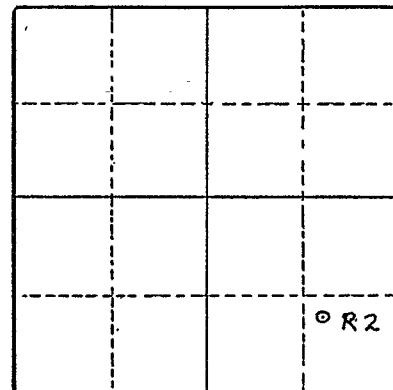

Section 1

FINISH:

AQUIFERS: Red rock from 138 to 185 ft.

WATER LEVEL:

PUMPING EQUIPMENT: Type centrifugal
Capacity G.P.M.

H.P.

WELL TESTS:

Drawdown ft. after hours G.P.M.

Drawdown ft. after hours G.P.M.

USE OF WATER irrigation Temp. °F. 19

SOURCE OF INFORMATION G-72

DRILLER or DIGGER

ADDITIONAL DATA:

Log X Water Level Measurements Chemical Analysis Aquifer Test

REMARKS:

STATE ENGINEER
Salem, Oregon

State Well No. 30/16-1R(2)
County Lake
Application No. G-72

Well Log

Owner: V. A. Withers Owner's No. 2

Driller: _____ Date Drilled _____

[illegible]