

STATE ENGINEER
Salem, Oregon

Lake
1514

Well Record

STATE WELL NO. 30/17-24R(1)
COUNTY Lake
APPLICATION NO.

OWNER: J. G. Foster

MAILING
ADDRESS:

LOCATION OF WELL: Owner's No.

CITY AND
STATE:

SE 1/4 SE 1/4 Sec. 24 T. 30 N. S. R. 17 E. W. W.M.

Bearing and distance from section or subdivision


corner

Altitude at well 4300

TYPE OF WELL: drilled Date Constructed

Depth drilled 327 Depth cased 220

CASING RECORD: 6 inch

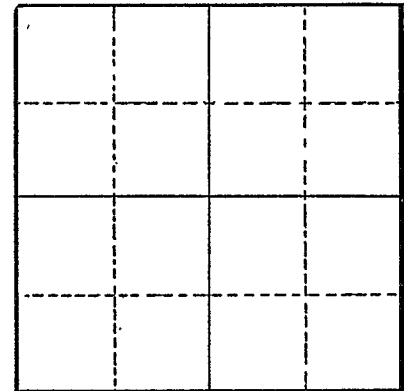

Section

FINISH:

AQUIFERS: basalt

WATER LEVEL: 12 flowing 100 gpm - May 1945

PUMPING EQUIPMENT: Type centrifugal H.P.
Capacity G.P.M.

WELL TESTS:

Drawdown ft. after hours G.P.M.

Drawdown ft. after hours G.P.M.

USE OF WATER irrigation Temp. °F., 19.

SOURCE OF INFORMATION Belated registration statement

DRILLER or DIGGER Mathier

ADDITIONAL DATA:

Log ^X Water Level Measurements Chemical Analysis Aquifer Test

REMARKS:

State Well No. 30/17-24R(1)
County Lake
Application No.

Owner: J. G. Foster Owner's No. _____

Driller: Lloyd Mather Date Drilled 1950

[illegible]