

STATE ENGINEER
Salem, Oregon

Well Record

STATE WELL NO. 30/18-19B(1)
COUNTY Lake
APPLICATION NO. _____

OWNER: J. G. Foster

MAILING
ADDRESS: _____

LOCATION OF WELL: Owner's No. _____

CITY AND
STATE: _____

NW $\frac{1}{4}$ NE $\frac{1}{4}$ Sec. 19 T. 30 N. S., R. 18 E. W., W.M.


Bearing and distance from section or subdivision

corner _____

Altitude at well 4315

TYPE OF WELL: Drilled Date Constructed 1918

Depth drilled 246 Depth cased _____

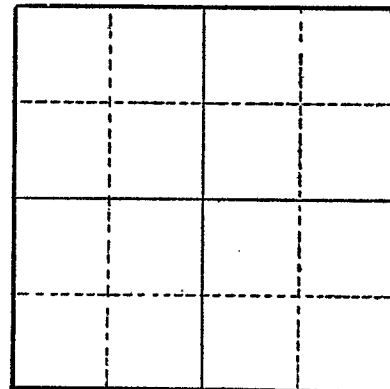

Section _____

CASING RECORD:

6 inch

FINISH:

AQUIFERS:

Basalt ?

WATER LEVEL:

6.7

PUMPING EQUIPMENT: Type Centrifugal H.P. _____
Capacity _____ G.P.M.

WELL TESTS:

Drawdown 11 ft. after _____ hours 1500 G.P.M.

Drawdown _____ ft. after _____ hours _____ G.P.M.

USE OF WATER Irrigation Temp. _____ °F., 19 _____

SOURCE OF INFORMATION Related registration statement

DRILLER or DIGGER Archie Hale

ADDITIONAL DATA:

Log _____ Water Level Measurements _____ Chemical Analysis _____ Aquifer Test _____

REMARKS:

Hardness 30 ppm, chloride 9 ppm; reported to pump 600 gpm with drawdown of 5 feet after 24 hours pumping.