

STATE ENGINEER
Salem, Oregon

Lake Well Record

STATE WELL NO. 30/23-180(1)
COUNTY Lake
APPLICATION NO. _____

OWNER: Favel-Utley Realty Co.

MAILING
ADDRESS: _____

LOCATION OF WELL: Owner's No. _____

CITY AND
STATE: _____

SW $\frac{1}{4}$ SE $\frac{1}{4}$ Sec. 18 T. 30 S., R. 23 W., W.M.

Bearing and distance from section or subdivision

corner _____


Altitude at well 4245

TYPE OF WELL: Drilled Date Constructed _____

Depth drilled 200 Depth cased _____

CASING RECORD:

8-6 inch

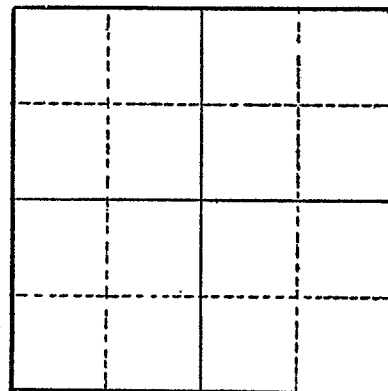

Section _____

FINISH:

AQUIFERS:

Volcanic rock

WATER LEVEL:

Flowing

PUMPING EQUIPMENT: Type None H.P. _____
Capacity _____ G.P.M.

WELL TESTS:

Drawdown _____ ft. after _____ hours _____ G.P.M.

Drawdown _____ ft. after _____ hours _____ G.P.M.

USE OF WATER _____ Temp. _____ °F. _____, 19 _____

SOURCE OF INFORMATION _____

DRILLER or DIGGER _____

ADDITIONAL DATA:

Log X Water Level Measurements _____ Chemical Analysis _____ Aquifer Test _____

REMARKS:

Drilled to test lake deposits for commercial amounts of sodium salts.

WELL IDENTIFICATION FORMOwner's Well Number: 2-3-1800**CURRENT WELL OWNER:**Phone (541)-947-5672
(541)-447-7258Name: James Evans, Jerry Evans, Tannie EvansMailing Address: 2662 NE Sunrise Lane Prineville, OR 97754City: Prineville State: OR Zip: 97754**RECEIVED**

MAR 13 2000

WELL LOCATION:LAKE 1544County: Lake Latitude: _____ Longitude: _____ **WATER RESOURCES DEP
SALEM, OREGON**Township: 30 N or S Range: 23 E or W Section: 18 SW 1/4 SE 1/4

Tax Lot Number: _____

Street Address of Well (if different from above): Near Alkali Lake, Oregon

If a well report is available for this well, please attach a copy of it to this form and return. It is not necessary for you to complete the remainder of the form if the well report is attached. If a well report is not available, please complete the remainder of the form to the best of your ability.

WELL INFORMATION:Start Card Number: Not Known Approx. Construction Date: 1952Well Constructor: Stanbery - RobinsonName of Owner at Time of Construction: Favel-Utley Realty Co.Well Depth (in feet): 200 Static Water Level (in feet): _____Diameter of Exposed Well Casing (in inches): 8-6"Does this well have a formal water right associated with it? Yes: _____ No: X If yes:

Application #: _____ Permit #: _____ Certificate #: _____

Please Return Completed Form to:

Oregon Water Resources Department
158 12th Street NE
Salem, OR 97310- 97301-4172

(Office use only)

Well Identification Number: 40894