

STATE ENGINEER
Salem, Oregon

lake
1961

Well Record

STATE WELL NO. 31/16-15B
COUNTY Lake
APPLICATION NO. GR-4011

OWNER: David T. O'Connor

MAILING ADDRESS:


LOCATION OF WELL: Owner's No. _____

CITY AND STATE:

Summer Lake, Oregon

NW 1/4 NE 1/4 Sec. 15 T. 31 S., R. 16 W., W.M.

Bearing and distance from section or subdivision corner
1220 feet South and 1500 feet West from the NE Corner, Section 15

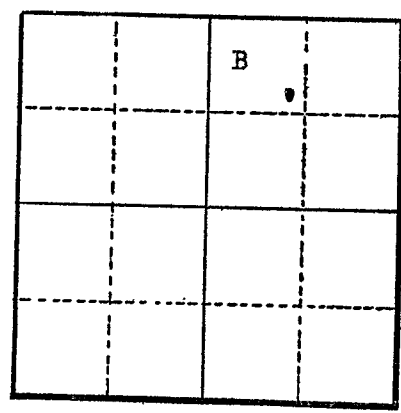

Section 15

Altitude at well 4175 feet

TYPE OF WELL: Drilled Date Constructed 1924

Depth drilled _____ Depth cased _____

CASING RECORD:
6-inch casing

FINISH:

AQUIFERS:

WATER LEVEL:

PUMPING EQUIPMENT: Type Gould Jet-O-Matic H.P. _____
Capacity _____ G.P.M.

WELL TESTS:
Drawdown 0 ft. after _____ hours 20 G.P.M.
Drawdown _____ ft. after _____ hours _____ G.P.M.

USE OF WATER Dom. Stk. Water, and Irri. Temp. _____ °F. _____, 19____

SOURCE OF INFORMATION GR-4137

DRILLER or DIGGER Williams, Frank & Leonard

ADDITIONAL DATA:
Log (NA) Water Level Measurements _____ Chemical Analysis _____ Aquifer Test _____

REMARKS: