

STATE ENGINEER
Salem, Oregon

Lake
1568

Well Record

STATE WELL NO. 31/16-27A
COUNTY Lake
APPLICATION NO.

OWNER: David T. O'Connor

MAILING
ADDRESS:

LOCATION OF WELL: Owner's No.


CITY AND
STATE:

Summer Lake, Oregon

NE 1/4 NE 1/4 Sec. 27 T. 31 S. R. 16 E., W.M.

Bearing and distance from section or subdivision

corner 100 ft. S. of the NW cor. sec. 27.

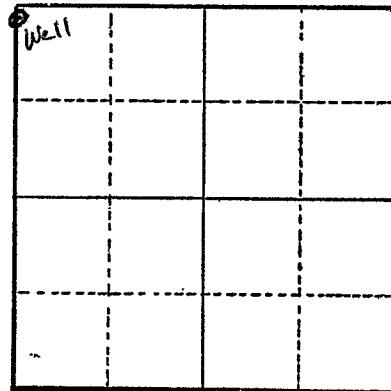

Section 27

Altitude at well 4200 ft.

TYPE OF WELL: Drilled Date Constructed 1940

Depth drilled 329 ft. Depth cased

CASING RECORD:

8 inch

FINISH:

AQUIFERS:

WATER LEVEL:

PUMPING EQUIPMENT: Type H.P.
Capacity G.P.M.

WELL TESTS:

Drawdown ft. after hours G.P.M.

Drawdown ft. after hours G.P.M.

USE OF WATER Irrigation & stock Temp. °F., 19

SOURCE OF INFORMATION Related registration statement

DRILLER or DIGGER C.E. Williams

ADDITIONAL DATA:

Log Water Level Measurements Chemical Analysis Aquifer Test

REMARKS:

Irrigation of 70 acres.