

STATE ENGINEER
Salem, Oregon

Well Record

STATE WELL NO. 33/17-11N(1)
COUNTY Lake
APPLICATION NO.

OWNER: John Withers

MAILING
ADDRESS:

LOCATION OF WELL: Owner's No.

CITY AND
STATE:

SW 1/4 SW 1/4 Sec. 11 T. 33 S. R. 17 E. W.M.

Bearing and distance from section or subdivision


corner

Altitude at well 4250

TYPE OF WELL: drilled Date Constructed

Depth drilled 363 Depth cased 363

CASING RECORD: 12 - 8 inch

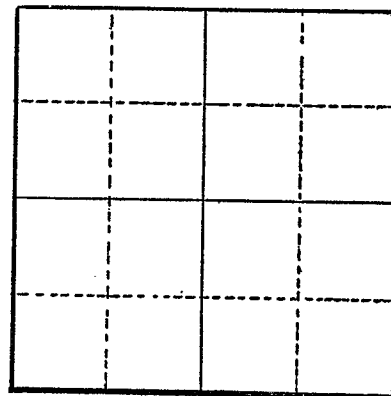

Section

FINISH:

AQUIFERS: Sand, broken rock

WATER LEVEL: flowing

PUMPING EQUIPMENT: Type turbine
Capacity 1000 G.P.M.

H.P.

WELL TESTS:

Drawdown ft. after hours G.P.M.

Drawdown ft. after hours G.P.M.

USE OF WATER irrigation Temp. 53 °F., 19.....

SOURCE OF INFORMATION

DRILLER or DIGGER

ADDITIONAL DATA:

Log Water Level Measurements Chemical Analysis Aquifer Test

REMARKS: Hardness 70 ppm, chloride 16 ppm; estimated flow, 5 gpm; reportedly will pump 1000 gpm continuously with 95 ft. drawdown; water has light odor of hydrogen sulfide; reportedly penetrated medium-loose sand & clay above 228 ft. & broken rock & solid rock below 228 ft.; reportedly a good flow of water at about 80 ft. and at bottom; 12 inches perforated at bottom; located near springs along edge of terrace.