## STATE OF OREGON WATER WELL REPORT (as required by ORS 537 765)


APR 17 1987

33\$ 18E-23ac

EPORT 37.765) ADD 1.7.196

(88)	s require	u by OR	5 997.700	,		APK	17 190,	•		/		
(1) 0	WNEI	<u>};</u>	n & So	_ (	Owner's We	II Number:	aran ware	(9) LOCATION OF WELL b	y legal d	escrip	tion:	
			11 & 50	11	-		7, 10 1EGC	N County Lake Latitude	, "	Longitude		' "
	P.O.							Township 33S N or S, R:	ange1{	BE	E or W.	WM.
City Pa	isely	7			StateOre	g• Zip	9/636	Section 23 SW				
(9) T	YPE (	NE 1377	DRK.				—	Tax Lot B			inician	
		Dec		٦.	1*.*			Street Address of Well (or nearest address				
☐ New				Recon	dition	☐ Abandon		Street Address of Well (or nearest address	.s)			
(3) D	RILL	MET	HOD:									
Rota:	ry Air	□ Re	tary Mud		Cable	Other		$\mid$ (10) STATIC WATER LEVE	L:			
								ft. below land surface.		Date	Mar.	18-87
								Artesian pressurelb. p				
/4\ D	DADA	OED.	HOD.									
	ROPO	_		☐ Indust	. 1			(11) WELL LOG: Ground ele	vation unk	nown		
3	estic	Com				Irrigation		Material		Г	WB?	SWL
Ther		☐ Injec		Other					From	То	WD;	SWL
<b>B</b> (	ORE I	IOLE	CONST	ruc	TION:		_	Hard Grey Basalt	306	329		
						415		Mild Brown Lava	329	_331_		igwdown
			Specia	al Standa	rds date of a	pproval		Hard Grey Basalt	331	337		
	HOLE	1		SEAL		Amou		Mild Brown Lava	337	339		
nete	er From	To	Material	From	То	sacks or p	pounds	Broken Lava, W/B	339	3 5 3	WB-	
R**	306	430	— .           — —		1. man 1			Hard Basalt	353	360		
	1500	750	xxx_	HOT G	istur	<del>eu</del>		White Clays	360	375		
								Brown & Blue Clays	375	430		
					<u></u> l				430	432		
How was	seal place	d? Meth	od 🗆 A	□в	$\Box$ c $\Box$	D 🗆 Е		Brown & Blue Clays	430	432		
Other	no	t dis	turbed						$\overline{}$			$\vdash$
Backfill r	olaced from	n	ft. to	ft.	Material	I						$\vdash$
			ft. to							ļ		<del>  </del>
					5,20 0. 6							
	ASIN(			0	Caral Di	astic Welded	1 Milmandad					
~ .	Diamete	r rroi !!+2		. 188								
Casing: _		12	300	• 100								
-		-										
_			_									
_												
Liner:												
_	*							<del>                                   </del>	_			
n inni loca	ation of sh	oe(s)										
		-	ONS/SO		NS.				+-		-	$\vdash$
			•			20			+			<del> </del> -
	Perforati	ons	Method			ne		·	+	<del>-</del>		$\vdash \vdash \vdash$
	Screens		Туре		M	aterial						
7		Slo		- D1	Tele/					ļ		
rom	To I	size	: Numbe:	r Diame	eter siz	e Casing	_					
	<del> </del>	+	+	+	-							
	<del> </del>			- <del> </del>		—						
	-	-	-			💾				_		
	ļ.    -	<u> </u>		<del></del>		🗓						
				1		□		D		10-	007	
	<u> </u>			<u> </u>		□		Date started Mar. 9-87	Completed	171.4	.o.=o./	
(8) W	ELL	rest	S: Minir	num te	esting tir	ne is 1 hou	ır	(unbonded) Water Well Constructor	Certificat	ion:		
` '					_	Flow	ing	I constructed this well in compli	ance with (	Oregon v	well cons	struction
	Pump		Bailer	X		☐ Arte		standards. Materials used and informati	on reported	above ar	e true to	my best
Yield g	(al/min	Pump	ing level	Dri	ill stem at	Time		knowledge and belief.				
						½ hr		Simul 1/1/1/1 1/1/1		Doto	Mar.	<b>22-</b> 8
50				4]	.5	1 hr	<u> </u>	Signed //////		_ Date _		
								(bonded) Water Well Constructor Co	ertification	1:		
								I accept responsibility for construc			d its co	mpliance
Temparat	ture of wa	ter -	175*	Dα	nth Artegier	r Flow Found _		with all Oregon water well standards.				
-	iter analys			By wh				knowledge and belief.				
	•			-		☐ Too little		( ) `D LY	11	/ h-	-9-87	
								Signed	Al-	ate	J =07	
-		-	Odor 🗆 Co	olored L	J Other			Orwail Buckner Wal	] Dr:11	ຳ ກ <i>ດ</i> ະ	Tna	
Depth of strata:								Company Orvail Buckner Well Drilling No.				

## **LAKE 1626**

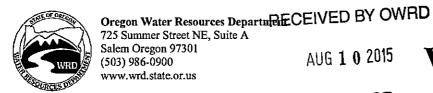

## **Application for**

## Well ID Number

SALEM, OR

AUG 1 0 2015

Do not complete if the well already has a Well Identification Number.

I. OWNER INFORMATION				
Current Owner Name (please print): Colat	nan Enterprises			
Mailing Address: PO Box 300				
City, State, Zip: Paisley, Oregon 97636				
	S ABOVE In Care Of (C			
Name & Address: Attn: Lynn Culp, Surp	rise Valley Electrification Corp.	(SVEC); 516 US	Highway 395 E.	
City, State, Zip: Alturas, CA, 96101				
II. <u>WELL LOCATION INFORMA</u>	TION (Please fill out as complete	lv as possible)		
Township: 33S (North / S			Section: 23	
Tax Lot: 1300 Co	ounty Lake	SW	<sub>1/4</sub> of the NW	 1/4
GPS Coordinates: _already assigned OV	VRD well log numbers: LAKE 16			
GPS Coordinates: _already assigned OV Street Address of Well, City: > 42.6	97274 - 120.55	8/3		•
If the property had a different street address				•
if the property had a different shoot address	- In the past.			
Use of Well (domestic, irrigation, commerce Date Well Constructed (or property built):  Owner at time the well was constructed (if Other Information: Well name: Little Ho	April 1964 Total Well D known): Ross Colahan	tion; application p epth: current 270'	ending for industrial  Casing Diameter: 16	11
SUBMITTED BY (please print): Lynn C	uln / Surprise Valley Electric Co	rn		
PHONE: (530) 233-3511	EMAIL &/or FAX: lynns	vec@frontier.com	 1	
PHONE: (edd) 256 5511	EMAIL &/or FAX:	.,,,,,,,,,,,,,,,,,,,,,,,,,,,,,,,,,,,,,,	· ·	
Send application to: Oregon Water Resource 0902. Applications are processed in the ore				3) 986-
For Office	ial Use Only by the Oregon Water	Resources Departn	nent:	
Received Date:	Well Log Numbe	r:	Well Identific	
8-10-15	LAKE 1620 LAKE 1620		<u>L-1199</u>	826
	A 855	(	-	

LAKE 52582 (ALT.) Well I.D. Number/2

Last Update: 4/30/14 WCC