

STATE ENGINEER
Salem, Oregon

Well Record

STATE WELL NO. 34/19-210(1)
COUNTY Lake
APPLICATION NO. 65213
65292

OWNER: Seitz, Lamon, & Son

MAILING
ADDRESS:

LOCATION OF WELL: Owner's No.

CITY AND
STATE:

N
E
SW $\frac{1}{4}$ SE $\frac{1}{4}$ Sec. 21 T. 34 S., R. 19 W., W.M.

Bearing and distance from section or subdivision


corner

Altitude at well 4375

TYPE OF WELL: drilled Date Constructed

Depth drilled 975 Depth cased 600

CASING RECORD: 15 - 6 inch

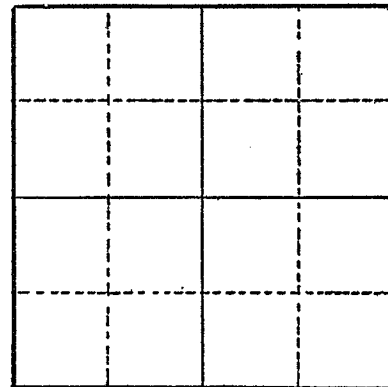

Section

FINISH:

AQUIFERS:

WATER LEVEL: 75.4

PUMPING EQUIPMENT: Type none

H.P.

Capacity G.P.M.

WELL TESTS:

Drawdown ft. after hours G.P.M.

Drawdown ft. after hours G.P.M.

USE OF WATER none Temp. °F. , 19

SOURCE OF INFORMATION

DRILLER or DIGGER

ADDITIONAL DATA:

Log Water Level Measurements Chemical Analysis Aquifer Test

REMARKS: Hardness 105 ppm, chloride 13 ppm