

STATE ENGINEER  
Salem, Oregon

Lake  
1887

# Well Record

STATE WELL NO. 36/24-33B(3)  
COUNTY Lake  
APPLICATION NO. G-1185


OWNER: Taylor Ranch Inc. MAILING ADDRESS: \_\_\_\_\_

LOCATION OF WELL: Owner's No. 3 CITY AND STATE: Lakeview, Oregon

NW 1/4 NE 1/4 Sec. 33 T. 36 N S., R. 24 E. W.M.

Bearing and distance from section or subdivision corner \_\_\_\_\_

Altitude at well \_\_\_\_\_

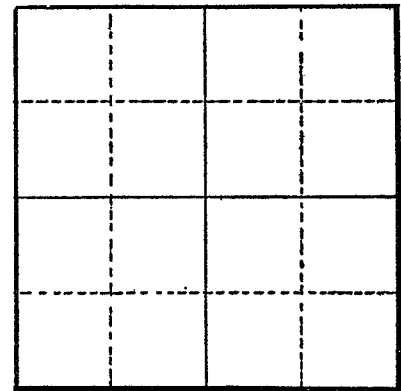

Section 33

TYPE OF WELL: drilled Date Constructed Oct. 1958

Depth drilled 262 ft. Depth cased 160 ft.

CASING RECORD: 14 inch casing set from 0 to 160 ft.

FINISH: 1/4" x 12" slots set on every other length of casing between 30 & 160 ft.

AQUIFERS: Gravel beds & lava's between 12 and 252 ft.

WATER LEVEL: 16.57 ft. below land surface

PUMPING EQUIPMENT: Type 50 hp - Electric - Layne pump H.P. \_\_\_\_\_  
Capacity \_\_\_\_\_ G.P.M.

WELL TESTS:  
Drawdown \_\_\_\_\_ ft. after \_\_\_\_\_ hours \_\_\_\_\_ G.P.M.  
Drawdown \_\_\_\_\_ ft. after \_\_\_\_\_ hours \_\_\_\_\_ G.P.M.

USE OF WATER irrigation Temp. \_\_\_\_\_ °F. \_\_\_\_\_, 19

SOURCE OF INFORMATION field visit 5/19/60 WSB

DRILLER or DIGGER Pat McGinley

ADDITIONAL DATA:  
Log  Water Level Measurements \_\_\_\_\_ Chemical Analysis \_\_\_\_\_ Aquifer Test \_\_\_\_\_

REMARKS:

### Water Level Record

OWNER: Con Taylor OWNER'S NO. #3

Description of measuring point: Air line or Top of casing on NE Side which is 0.5 feet above LSD.

| Date    | Water Level<br>Feet (above)<br>(below)<br>Land Surface | Remarks | Date | Water Level<br>Feet (above)<br>(below)<br>Land Surface | Remarks |
|---------|--|---------|------|--|---------|
| 5-19-60 | 16.57  | WSB     |      |  |         |
| 9-14-60 | 25.00  | WSB     |      |  |         |
| 6-13-61 | 18.47  | WSB     |      |  |         |
|         |  |         |      |  |         |
|         |  |         |      |  |         |
REMARKS: \_\_\_\_\_

\_\_\_\_\_

\_\_\_\_\_