

Lake
2340

Well Record

OWNER: E. M. Binnion


MAILING ADDRESS:

LOCATION OF WELL: Owner's No.

CITY AND STATE:

..... 1/4 1/4 Sec. T. N. E. S., R. W., W.M.

Bearing and distance from section or subdivision corner

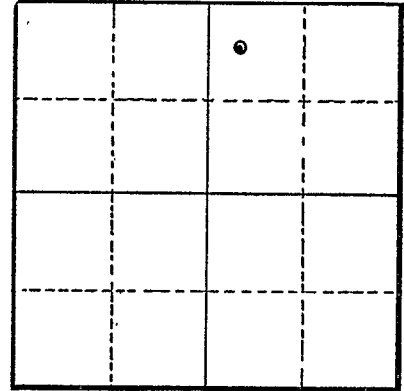

Section 4

Altitude at well

TYPE OF WELL: Drilled Date Constructed 1943

Depth drilled 70 Depth cased 70

CASING RECORD:

10" to 20'
6" to 70'

FINISH:

AQUIFERS:

WATER LEVEL:

Flow

PUMPING EQUIPMENT: Type H.P. Capacity G.P.M.

WELL TESTS:

Drawdown ft. after hours G.P.M.
Drawdown ft. after hours G.P.M.

USE OF WATER Domestic & irrigation Temp. °F. , 19

SOURCE OF INFORMATION

DRILLER or DIGGER

ADDITIONAL DATA:

Log Water Level Measurements Chemical Analysis Aquifer Test

REMARKS:

