

STATE ENGINEER  
Salem, Oregon

Lake  
2457

# Well Record

STATE WELL NO. 39/20-10M(1)  
COUNTY Lake  
APPLICATION NO. U-295

OWNER: Fremount Sawmill Co.


MAILING ADDRESS:

LOCATION OF WELL: Owner's No.

CITY AND STATE: Lakeview, Oregon

NW 1/4 SW 1/4 Sec. 10 T. 39 N. S., R. 20 E., W.M.

Bearing and distance from section or subdivision corner S. 0° 2' E. from W 1/4 cor. Sec. 10, T. 39 S., R. 20 E., W.M.

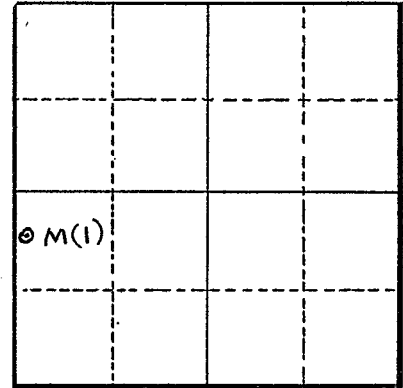

Altitude at well

TYPE OF WELL: Date Constructed 12/1/47

Depth drilled 497 Depth cased

Section 10

CASING RECORD: 10 in. diameter

FINISH:

AQUIFERS:

WATER LEVEL: 20 ft.

PUMPING EQUIPMENT: Type H.P. 20  
Capacity 600 G.P.M.

WELL TESTS:

Drawdown ft. after hours G.P.M.  
Drawdown ft. after hours G.P.M.

USE OF WATER Log Pond & Fire Protection Temp. °F. 19

SOURCE OF INFORMATION U-295

DRILLER or DIGGER Frank Williams, Lakeview, Oregon

ADDITIONAL DATA:

Log Water Level Measurements Chemical Analysis Aquifer Test

REMARKS:





**Water Resources Department**  
**MILL CREEK OFFICE PARK**  
555 13th STREET N.E., SALEM, OREGON 97310

**RECEIVED**

AUG 13 1979

WATER RESOURCES DEPT  
SALEM, OREGON

PHONE 378-8455

July 23, 1979


Bill Williams  
Aqua Irrigation Drilling Co., Inc.  
P.O. Box 1310  
Lakeview, Oregon 97630

Dear Mr. Williams:

This is to acknowledge receipt of your request to use bentonite as a plugging material for the abandonment of the Lake County - West Wood Park geothermal #1 located in the SW $\frac{1}{4}$  SW $\frac{1}{4}$  of Section 18, T. 39S, R. 20E, W.M., (100' E. of W. line, 950' N. of S. line, Lot 13 Unit 2 Westwood Park, Lakeview, Oregon). Your letter requests permission to use a mixture of Quik-Tral and Quik-Gel as an abandonment material in the well.

You are hereby given special permission to abandon the subject well using the above stated materials. The bentonite grout material must be placed in a positive manner from the bottom upward as required by the general well construction standards for cement grout or concrete.

Sincerely,

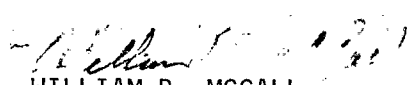  
WILLIAM B. MCCALL  
Hydrogeologist

WBM:caf  
cc: Howard Daggett, Watermaster, District #12

