

STATE ENGINEER
Salem, Oregon

Lake 2468

Well Record

STATE WELL NO. 39/20-15A(1)
COUNTY Lake
APPLICATION NO. _____

OWNER: City of Lakeview


MAILING
ADDRESS: _____

LOCATION OF WELL: Owner's No. _____

CITY AND
STATE: _____

NE 1/4 NE 1/4 Sec. 15 T. 39 ^{N.}S., R. 20 ^{E.}W., W.M.

Bearing and distance from section or subdivision
corner _____

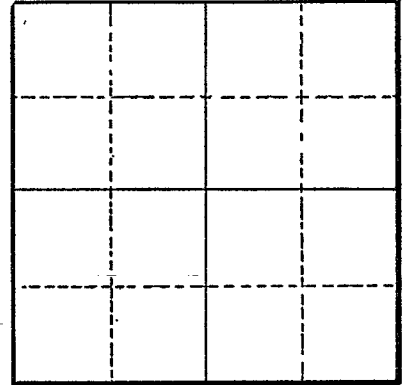

Section _____

Altitude at well 4808

TYPE OF WELL: Drilled Date Constructed _____

Depth drilled 2380 Depth cased 2072

CASING RECORD:

12-8 inch

FINISH:

AQUIFERS:

Faulted zone in volcanic rock

WATER LEVEL:

50

PUMPING EQUIPMENT: Type Turbine H.P. _____
Capacity _____ G.P.M.

WELL TESTS:

Drawdown _____ ft. after _____ hours _____ G.P.M.

Drawdown _____ ft. after _____ hours _____ G.P.M.

USE OF WATER Public supply Temp. 100 °F. _____, 19. _____

SOURCE OF INFORMATION

DRILLER or DIGGER

ADDITIONAL DATA:

Log _____ Water Level Measurements _____ Chemical Analysis _____ Aquifer Test _____

REMARKS:

Hardness 30 ppm, chloride 13 ppm.
Reported to pump warm water (86°) for first 3-4 hours; thereafter water gets hotter;
temp. 110° F. at depth of 1700 feet and 196° F. at 2380 feet; drawdown 320 feet after
10 hours, pumping at about 250 gpm.

STATE ENGINEER
Salem, Oregon

Well Record

STATE WEEL NO. 39/20-15A
COUNTY Lake
APPLICATION NO.

OWNER: City of Lakaview

MAILING
ADDRESS:

LOCATION OF WELL: Owner's No.

CITY AND
STATE:

NE 1/4 NE 1/4 Sec. 15 T. 39 S., R. 20 W., W.M.

Bearing and distance from section or subdivision
corner

Well #5

Altitude at well 4808

TYPE OF WELL: Drilled, Date Constructed

Depth drilled 2380 Depth cased 2072 350

| | | | |
|--|--|--|--|
| | | | |
| | | | |
| | | | |
| | | | |

Section

CASING RECORD:

12-8 inch

FINISH:

AQUIFERS:

Faulted zone in volcanic rock

WATER LEVEL:

50

PUMPING EQUIPMENT: Type Turbine HP.
Capacity G.P.M.

WELL TESTS:

Drawdown ft. after hours G.P.M.
Drawdown ft. after hours G.P.M.

USE OF WATER Public supply Temp. 100 °F., 19...

SOURCE OF INFORMATION

DRILLER or DIGGER

ADDITIONAL DATA:

Log Water Level Measurements Chemical Analysis Aquifer Test

REMARKS:

Hardness 30 ppm, chloride 13 ppm.
Reported to pump warm water (86°) for first 3-4 hours; thereafter water gets hotter;
temp. 110° F. at depth of 1700 feet and 196° F. at 2380 feet; drawdown 320 feet after
10 hours, pumping at about 250 gpm.

RECEIVED
AUG 21 1979

WATER RESOURCES DEPT
SALEM, OREGON