

STATE ENGINEER
Salem, Oregon

Lake 2498

Well Record


STATE WELL NO. 39/20-160(1)
COUNTY Lake
APPLICATION NO. U-646

OWNER: Lakeview Water Commission MAILING ADDRESS: _____

LOCATION OF WELL: Owner's No. #4 CITY AND STATE: Lakeview, Oregon

NE 1/4 NW 1/4 Sec. 16 T. 39 ^{N.}S., R. 20 ^{E.}W., W.M.

Bearing and distance from section or subdivision corner N 83° 42' W 72.9 ft. from SE corner
Lot 1, Block 128, Oregon Valley Land Co.
First Addition to Lakeview, Ore.

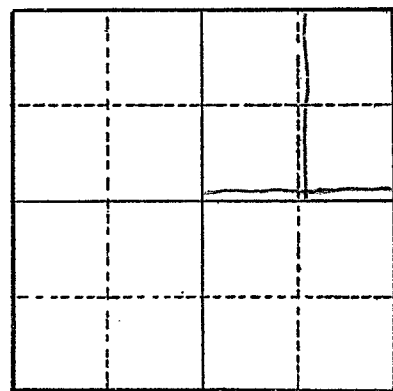

Section 16

Altitude at well _____

TYPE OF WELL: Drilled Date Constructed Mar. 1954

Depth drilled 283 ft Depth cased _____

CASING RECORD:

FINISH:

AQUIFERS:

WATER LEVEL:
1955 - 16 ft;

PUMPING EQUIPMENT: Type _____ H.P. _____
Capacity _____ G.P.M.

WELL TESTS:
Drawdown 49 ft. after _____ hours 350 G.P.M.
Drawdown _____ ft. after _____ hours _____ G.P.M.

USE OF WATER municipal Temp. _____ °F., 19. _____

SOURCE OF INFORMATION _____

DRILLER or DIGGER _____

ADDITIONAL DATA:
Log Water Level Measurements _____ Chemical Analysis _____ Aquifer Test _____

REMARKS:

