

STATE ENGINEER
Salem, Oregon

Lake 2502

Well Record

STATE WELL NO. 39/20-16J(1)
COUNTY Lake
APPLICATION NO. _____

OWNER: City of Lakeview

MAILING
ADDRESS: _____

LOCATION OF WELL: Owner's No. _____

CITY AND
STATE: _____

NE 1/4 SE 1/4 Sec. 16 T. 39 S., R. 20 W., W.M.


Bearing and distance from section or subdivision

corner _____

Altitude at well 4745

TYPE OF WELL: Drilled Date Constructed _____

Depth drilled 230 Depth cased _____

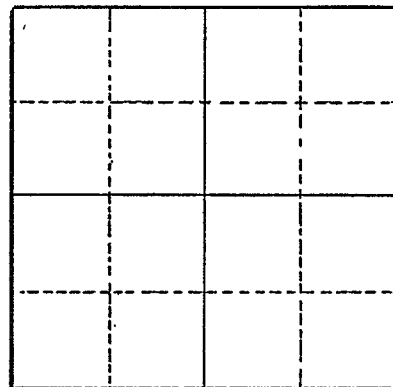

Section _____

CASING RECORD:

18 inch

FINISH:

AQUIFERS:

WATER LEVEL:

20.5

PUMPING EQUIPMENT: Type Turbine H.P. _____
Capacity 500 G.P.M.

WELL TESTS:

Drawdown _____ ft. after _____ hours _____ G.P.M.

Drawdown _____ ft. after _____ hours _____ G.P.M.

USE OF WATER Public supply Temp. 59 °F. _____, 19____

SOURCE OF INFORMATION _____

DRILLER or DIGGER _____

ADDITIONAL DATA:

Log Water Level Measurements _____ Chemical Analysis _____ Aquifer Test _____

REMARKS:

Hardness 48 ppm, chloride 5 ppm. Drilled to 360 feet plugged at 230 feet to cut off warm water.

