

STATE ENGINEER  
Salem, Oregon

Lake  
2506

# Well Record

STATE WELL NO. 39/20-17D(1)  
COUNTY Lake  
APPLICATION NO.


OWNER: Favell-Utley Realty Co.

MAILING ADDRESS:  
CITY AND STATE:

LOCATION OF WELL: Owner's No.

NW 1/4 NW 1/4 Sec. 17 T. 39 N. S., R. 20 E., W.M.

Bearing and distance from section or subdivision corner

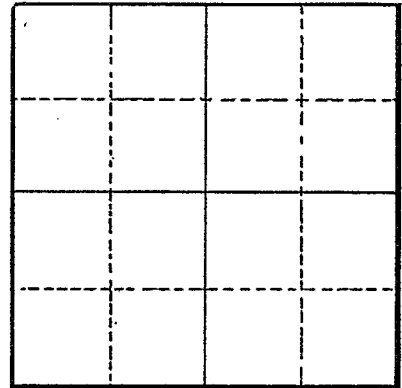

Section

Altitude at well 4746

TYPE OF WELL: Drilled Date Constructed

Depth drilled 240 Depth cased

### CASING RECORD:

16 inch

### FINISH:

### AQUIFERS:

### WATER LEVEL:

3.3

PUMPING EQUIPMENT: Type Turbine H.P.  
Capacity 600 G.P.M.

### WELL TESTS:

Drawdown ft. after hours G.P.M.  
Drawdown ft. after hours G.P.M.

USE OF WATER Irrigation Temp. °F., 19

SOURCE OF INFORMATION

DRILLER or DIGGER

### ADDITIONAL DATA:

Log  Water Level Measurements Chemical Analysis Aquifer Test

### REMARKS:

Reportedly flowed when drilled.

