NOTICE TO WATER WELL CONTRACTOR
The oficinal and first copy of this report
are to be filed with the


WATER RESOURCES DEPARTMENT, SALEM, OREGON 97310 within 30 days from the date of well completion.

WATER WELL REPORT

STATE OF OREGON

(Please type or print)

(Do not write above this line)

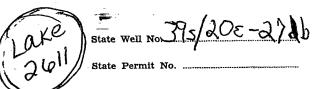

Address 123 N. W. F. ANDERS 51. (2) TYPE OF WORK (check): New Well X Deepening Reconditioning Abandon Bearing and distance from section or subdivision corne 20 ft. of US Hwy 395 4 300 N. Boundary of Selfy (3) TYPE OF WELL: (4) PROPOSED USE (check): Domestic Industrial Municipal Static level 20 ft. below land surface.	r F7, S0	w.m.
Address 23 1, 1, FANDERS 51, 1, 1, 1, 1, 1, 1, 1	r F7, S0	w.m.
Bearing and distance from section or subdivision corne	FT, So	s, of
(2) TYPE OF WORK (check): New Well X Deepening \(\text{ Reconditioning } \) Reconditioning \(\text{ Abandon } \) If abandonment, describe material and procedure in Item 12. (3) TYPE OF WELL: (4) PROPOSED USE (check): Domestic \(\text{ Industrial } \text{ Municipal } \) Depth at which water was first found \(\text{ 50} \) Static level \(\text{ 200 FT } \) Static level \(\tex	FT, So	ft.
New Well Deepening Reconditioning Abandon If abandonment, describe material and procedure in Item 12. (3) TYPE OF WELL: (4) PROPOSED USE (check): Domestic Industrial Municipal Domestic Industrial Municipal Static level 26 ft. below land surface.	Date F-	ft.
If abandonment, describe material and procedure in Item 12. (3) TYPE OF WELL: (4) PROPOSED USE (check): Domestic Industrial Municipal Static level Static level		
(3) TYPE OF WELL: (4) PROPOSED USE (check): Depth at which water was first found 50 Static level 10 ft. below land surface.		ft. -15-80
Domestic Industrial Municipal Static level 10 ft. below land surface.		_15-80
de L' Jetted L'		-15-80
	Date	
Dug Bored I Irrigation Test Well Other Artesian pressure lbs. per square inch.		

"Diam. fromft. toft. Gage ft. toft. Gage	cture of r	materials;
"Diam. fromft. toft. Gage and show thickness and nature of each stratum and a with at least one entry for each change of formation. Rep		
(6) PERFORATIONS: Perforated? Yes No. position of Static Water Level and indicate principal wa	ter-beari	ng strata.
Type of perforator used MATERIAL From	То	SWL
Size of perforations in. by in. SEE ATTACHED SHEET.		
perforations fromft. toft.		<u> </u>
perforations fromft. toft.	 	
perforations fromft. toft.		-
(7) SCREENS: Well screen installed? Yes No		
Manufacturer's Name		
Type Model No.		
Diam. Slot size Set from ft. to ft.		
Diam. Slot size Set from ft. to ft.		
(8) WELL TESTS: Drawdown is amount water level is lowered below static level	-	
lowered below static level	 	
a pump test made? Yes No If yes, by whom? WATER RESOURCES DEPT	+	
Yield: gal./min. with ft. drawdown after hrs. SALEM, OREGON	-	
" " " " TAMENTA VICEOUT	†	
n n n		
Fr test 100 gal./min. with ft. drawdown after hrs.		
Artesian flow g.p.m.	<u> </u>	<u></u>
Temperature of water/90 Depth artesian flow encounteredft. Work started 7-10 1980 Completed 9-	- 15	1900
(9) CONSTRUCTION: 1 Date well drilling machine moved off of well 4.	20	1950
Well seal-Material used NEFT (EMENT Drilling Machine Operator's Certification:	,	
Well sealed from land surface toft. This well was constructed under my direc Materials used and information reported above		
Diameter of well bore to bottom of sealin. best knowledge and belief.	0	/ 😕
(Drilling Machine Operator)	9-24	, 19.00
Number of sacks of cement used in well seal	, <u>Y</u>	******
How was cement grout placed?		
Water Well Contractor's Certification:		٠
This well was drilled under my jurisdiction a true to the best of my knowledge and belief.	nd this	report is
Was a drive shoe used? Tyes No Plugs Size: location ft.		
Did any strata contain unusable water \(\subseteq \text{Yes} \(\subseteq \text{No} \) (Person, firm or corporation) (7)	Type or pr	int)
Type of water? depth of strata Address 1.0. Dax 1310, LAKEVIEW	CR.	97630
Method of sealing strata off [Signed] W. W. Williams		
Was well gravel packed? Yes No Size of gravel: (Water Well Contractor)	rs/	CZ-
Gravel placed fromft_ toft. Contractor's License No. 665 Date /0-2	28	, ₁₉ ප්ර

GEOTHERMAL
CORPORATION
200 S.W. Market Street, Suite 1900
Portland, Oregon 97201

Lake Co. 395/20 E 2/db 20-Northwest Deotherns 200 1355/ Seep

Lithologic Log

(503) 226-4211

Gulf Barry #2

```
gravel:
                silty clay
         30!
                grave1
         50.
                sandy clay
 301
         901
                gravel
 50
        100
                sand
 90
                gray clay
        115'
100'
                green gray welded tuff
115'
        130
                grayish green lithic tuff
        2261
130' -
                green welded tuff
        250'
226!
                green to brown lithic tuff
         421'
250'
                calcite vein
        4221
421'
                green to brown lithic tuff breccia
         910'
423' -
                gray green andesite
         930 %
910
                basalt
9301
         950!
                dark gray basaltic andesite
950' - 1010'
                green gray andesite
1010' - 1050'
                lithic breccia
1050' - 1060'
                black basalt
1060' - 1070'
                dark gray to green tuff breccia
1070' - 1160'
                greenish gray andesite
1160' - 1190'
                green to brown lithic breccis
1190' - 1230'
                 greenish gray andesite
1230! - 1245!
                brownish green lithic breccia
1245' - 1250'
                 green dacite
1250' - 1270'
                 lithic breccia
1270' - 1280'
                 dark gray andesite
1280' - 1290'
                 tuff breccia
1290' - 1310'
                 gray andesite
[1310' - 1320<u>'</u>
                 lithic breccia
1320! - 1355!
```

RECEIVED

OCT 3 1 1980
WATER RESOURCES DEPT
SALEM, OREGON