

STATE ENGINEER
Salem, Oregon

Lake 2755
Well Record


STATE WELL NO. 40/19-2D(1)
COUNTY Lake
APPLICATION NO. U-343

OWNER: Floyd Reed MAILING ADDRESS: _____

CITY AND STATE: Lakeview, Oregon

LOCATION OF WELL: Owner's No. _____
NW 1/4 NW 1/4 Sec. 2 T. 40 S. R. 19 W., W.M.

Bearing and distance from section or subdivision
corner 527° 42' 1400.5' from NW cor. Sec. 2

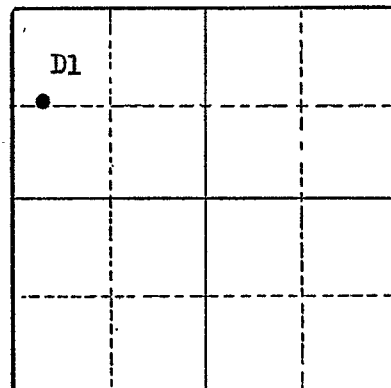

Altitude at well 4749 (USGS)

TYPE OF WELL: Drilled Date Constructed 1949

Depth drilled 709 Depth cased 690

Section _____

CASING RECORD:

10 inch set to 690'

FINISH:

AQUIFERS:

WATER LEVEL:

Flows

PUMPING EQUIPMENT: Type None H.P. _____
Capacity _____ G.P.M.

WELL TESTS:

Drawdown _____ ft. after _____ hours _____ G.P.M.

Drawdown _____ ft. after _____ hours _____ G.P.M.

USE OF WATER Stock & domestic Temp. _____ °F. _____, 19____

SOURCE OF INFORMATION U-343 USGS

DRILLER or DIGGER Jud Pierce

ADDITIONAL DATA:

Log X Water Level Measurements _____ Chemical Analysis _____ Aquifer Test _____

REMARKS:

U.S.G.S. reports that well was flowing approximately 400 gpm in August 1949. Flow greatly reduced by 1957.

STATE ENGINEER
Salem, Oregon

State Well No. 40/19-2D(1)
County Lake
Application No. U-343

Well Log

Owner: Floyd Reed Owner's No. _____

Driller: Jud Pierce Date Drilled 1949

CHARACTER OF MATERIAL	(Feet below land surface)		Thickness (feet)
	From	To	
Soil & silt	0	4	4
Gravel	4	21	17
Clay, blue	21	32	11
Sand, fine	32	38	6
Clay	38	42	4
Sand, fine	42	49	7
Clay, blue	49	55	6
Sand, medium	55	62	7
Sand, fine	62	99	37
Sand, coarse	99	104	5
Sand, fine	104	109	5
Clay, blue	109	214	105
Pumice	214	217	3
??	217	297	80
Clay	297	353	56
Sand, fine	353	357	4
Clay, with thin layers of fine sand	357	521	164
Sand,	521	529	8
Clay	529	557	28
Sand, medium	557	568	11
Clay	568	615	47
Sand, medium	615	637	22
Clay	637	640	3
Sand, medium	640	651	11

State Well No. 40/19-2D(1)
County Lake
Application No. U-343

Owner: Floyd Reed Owner's No. _____

Driller: Jud Pierce Date Drilled _____

[illegible]