

STATE ENGINEER
Salem, Oregon

Lake 2796
Well Record

STATE WELL NO. 40/19-15M(1)
COUNTY Lake
APPLICATION NO. _____

OWNER: George Stockberger


MAILING
ADDRESS: _____

LOCATION OF WELL: Owner's No. _____

CITY AND
STATE: _____

NW $\frac{1}{4}$ SW $\frac{1}{4}$ Sec. 15 T. 40 ^{N.} S., R. 19 ^{E.} W., W.M.

Bearing and distance from section or subdivision
corner _____

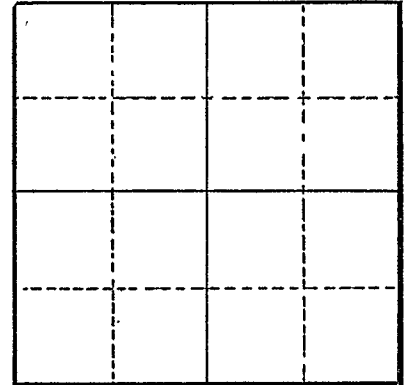

Altitude at well 4733

TYPE OF WELL: Bored Date Constructed _____

Depth drilled 17.9 Depth cased _____

Section _____

CASING RECORD:

9 inch

FINISH:

AQUIFERS:

WATER LEVEL:

6.7

PUMPING EQUIPMENT: Type Piston H.P. _____
Capacity _____ G.P.M.

WELL TESTS:

Drawdown _____ ft. after _____ hours _____ G.P.M.

Drawdown _____ ft. after _____ hours _____ G.P.M.

USE OF WATER Stock Temp. 52 °F. _____, 19 _____

SOURCE OF INFORMATION _____

DRILLER or DIGGER _____

ADDITIONAL DATA:

Log _____ Water Level Measurements _____ Chemical Analysis _____ Aquifer Test _____

REMARKS:

Hardness 70 ppm, chloride 26 ppm.