

STATE ENGINEER
Salem, Oregon

Well Record

STATE WELL NO. 26/15-6B(1)
COUNTY Lake
APPLICATION NO. U-743

JACK KITTERIDGE

Lake 378

OWNER: A. E. Albertson


MAILING ADDRESS: Philomath, Oregon

LOCATION OF WELL: Owner's No. 2 - Permit 665

CITY AND STATE: _____

NE 1/4 NW 1/4 Sec. 6 T. 26 S., R. 15 E., W.M.

Bearing and distance from section or subdivision corner 60 ft. S. & 2000 ft. W. of NE cor. Sec. 6

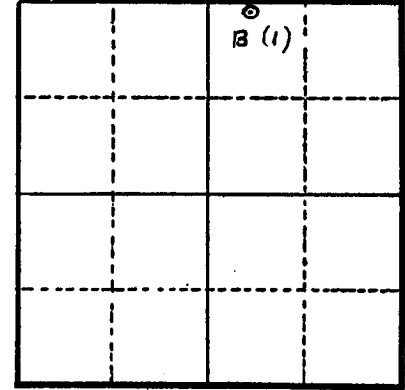

Section 6

Altitude at well _____

TYPE OF WELL: Drilled Date Constructed Oct. Nov. 55

Depth drilled 317 Depth cased 119

CASING RECORD: 16 inch, set from 0 to 36.7 ft.
12 inch, set from 0 to 119 ft.

FINISH: open hole below casing

AQUIFERS: 26 ft. below land surface, Nov. 29, 1955

WATER LEVEL: _____

PUMPING EQUIPMENT: Type _____ H.P. _____
Capacity _____ G.P.M.

WELL TESTS:
Drawdown 41 ft. after 6 hours pumping 800 G.P.M.
Drawdown _____ ft. after _____ hours _____ G.P.M.

USE OF WATER Irrigation 298 ac. with well #1 Temp. _____ °F. _____, 19____

SOURCE OF INFORMATION Well Drillers Report

DRILLER or DIGGER Claude A. Shafer

ADDITIONAL DATA:
Log X Water Level Measurements _____ Chemical Analysis _____ Aquifer Test _____

REMARKS: Permit 665 -

