

STATE ENGINEER
Salem, Oregon

Well Record

STATE WELL NO. 26/15-29E(1)
COUNTY Lake
APPLICATION NO. U-509

OWNER: Richard Schaub

MAILING
ADDRESS:

LOCATION OF WELL: Owner's No.


CITY AND
STATE:

Fort Rock, Oregon

SW 1/4 NW 1/4 Sec. 29 T. 26 S., R. 15 W., W.M.

Bearing and distance from section or subdivision

corner N. 8° 55' E. - 1150.5 ft. from W. cor. Sec.

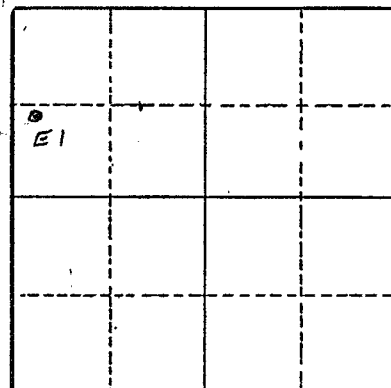

Altitude at well 4,320 USGS

TYPE OF WELL: drilled Date Constructed

Depth drilled 132 Depth cased 10

Section 29

CASING RECORD: 12 inch, set to 10 ft.

FINISH: Open hole below casing

AQUIFERS: Gravel from 130 to 132 ft.

WATER LEVEL: 26.40 ft. below land surface, Nov. 9, 1940

PUMPING EQUIPMENT: Type Turbine H.P.
Capacity G.P.M.

WELL TESTS:

Drawdown Less than 40 ft. after hours pumping 800 G.P.M.

Drawdown ft. after hours G.P.M.

USE OF WATER Irrigation 40 acres Temp. °F., 19

SOURCE OF INFORMATION U-509, USGS Report

DRILLER or DIGGER

ADDITIONAL DATA:

Log Water Level Measurements Chemical Analysis Aquifer Test

REMARKS: Permit 513

Sand, tuff, and lava from 30 to 130 ft.

Water Level Record

OWNER: Richard Schaub OWNER'S NO. _____

Description of measuring point: Bottom lip of discharge pipe at inside
casing - + 0.3 feet above LSP.

Date	Water Level Feet (above) (below) Land Surface	Remarks	Date	Water Level Feet (above) (below) Land Surface	Remarks
11/9/40	26.40				
5/22/56	22.1	WSB, ← ? ok			
8-29-56	22.68	"			
10-16-56	22.58	WSB.			
4-30-57	23.07	WSB			
8-19-57	41.61	WSB Pumping -			
10-24-57	22.43	WSB st.			
4-22-58	22.01	WSB.			
10-14-58	-	WSB can't get in -			
5-13-59	22.40	JES-WSB			
10-16-59	21.59	WSB			
4-28-60	21.68	JES-WSB			
10-25-60	21.69	WSB			
5-4-61	21.97	WSB			
10-17-61	22.02	WSB + RD			

REMARKS: See hydrograph