

ORIGINAL
File Original, and
Duplicate with the
STATE ENGINEER,
SALEM, OREGON

DEC 7 1955

WATER WELL DRILLERS REPORT

STATE OF OREGON

Do Not State Well No.

Fill In

State Permit No.

2415-32 E (2)

App 508 Per mit 512

(1) OWNER: SALEM, OREGON

Name Richard Schaub

Address Fort Rock

(2) LOCATION OF WELL:

County Lake Owner's number, if any— 2

R. F. D. or Street No.

Bearing and distance from section or subdivision corner

(3) TYPE OF WORK (check):

New well ☐ Deepening ☒ Reconditioning ☐ Abandon ☐
Abandonment, describe material and procedure in Item 11.

(4) PROPOSED USE (check):

Domestic ☐ Industrial ☐ Municipal ☐
Irrigation ☒ Test Well ☐ Other ☐

(5) EQUIPMENT:

Rotary ☐
Cable ☒
Dug Well ☐

CASING INSTALLED:

Threaded ☐ Welded ☐

FROM	ft. to	ft.	Diam.	Gage or Wall
"	16	"	14	1.44
"	"	"	"	"
"	"	"	"	"
"	"	"	"	"
"	"	"	"	"

If gravel packed

Diameter of Bore	from ft.	to ft.
"	"	"
"	"	"
"	"	"
"	"	"
"	"	"

Type and size of shoe or well ring

Size of gravel:

Describe joint

(7) PERFORATIONS:

Type of perforator used

SIZE	of perforations	in., length, by	in.
FROM	ft. to	ft.	No. of rows
"	"	"	"
"	"	"	"
"	"	"	"
"	"	"	"

SCREENS:

Give Manufacturer's Name, Model No. and Size

(8) CONSTRUCTION:

Was a surface sanitary seal provided? ☐ Yes ☐ No To what depth 1 ft.

Were any strata sealed against pollution? ☐ Yes ☐ No

If yes, note depth of strata

FROM	ft. to	ft.
"	"	"

METHOD OF SEALING

(9) WATER LEVELS:

Depth at which water was first found 1 ft.

Standing level before perforating 1 ft.

Standing level after perforating 1 ft.

Log Accepted by:

[Signed] _____ Dated _____, 19____
Owner

(10) WELL TESTS:

Was a pump test made? ☒ Yes ☐ No If yes, by whom? B. Yates

Yield: 500 gal./min. with 21 ft. draw down after 10 hrs.
" 1800 " 40 " 5 "

Artesian flow _____ g.p.m.

Shut-in pressure _____ lbs. per square inch.

Bailer test _____ g.p.m. with _____ ft. drawdown

Temperature of water _____ Was a chemical analysis made? ☐ Yes ☐ No

Was electric log made of well? ☐ Yes ☐ No

(11) WELL LOG:

Diameter of well 12 inches.

Total depth 225 ft. Depth of completed well 225 ft.

Formation: Describe by color, character, size of material and structure, and show thickness of aquifers and the kind and nature of the material in each stratum penetrated, with at least one entry for each change of formation.

197 to 225 ft. Rock

Ground elevation at well site _____ feet above mean sea level.

Work started Aug. 5, 1955, Completed Aug. 18, 1955.

Well Driller's Statement:

This well was drilled under my jurisdiction and this report is true to the best of my knowledge and belief.

NAME S.M. Munnerlyn

(Person, firm, or corporation) (Typed or printed)

Address Fort Rock Oregon

Driller's well number 2.

[Signed] S.M. Munnerlyn

(Well Driller)

License No. 102 Dated Aug. 19, 1955

STATE ENGINEER
Salem, Oregon

Well Record

STATE WELL NO. 26/15-32E(2)
COUNTY Lake
APPLICATION NO. U-512

OWNER: Richard Schaub

MAILING
ADDRESS:

LOCATION OF WELL: Owner's No. 2

CITY AND
STATE:


Fort Rock, Oregon

SW 1/4 NW 1/4 Sec. 32 T. 26 N. S. R. 15 E. W.M.

Bearing and distance from section or subdivision

corner N. 14° 05' E. 1328.5 ft. from W¹ cor.

Sec. 32

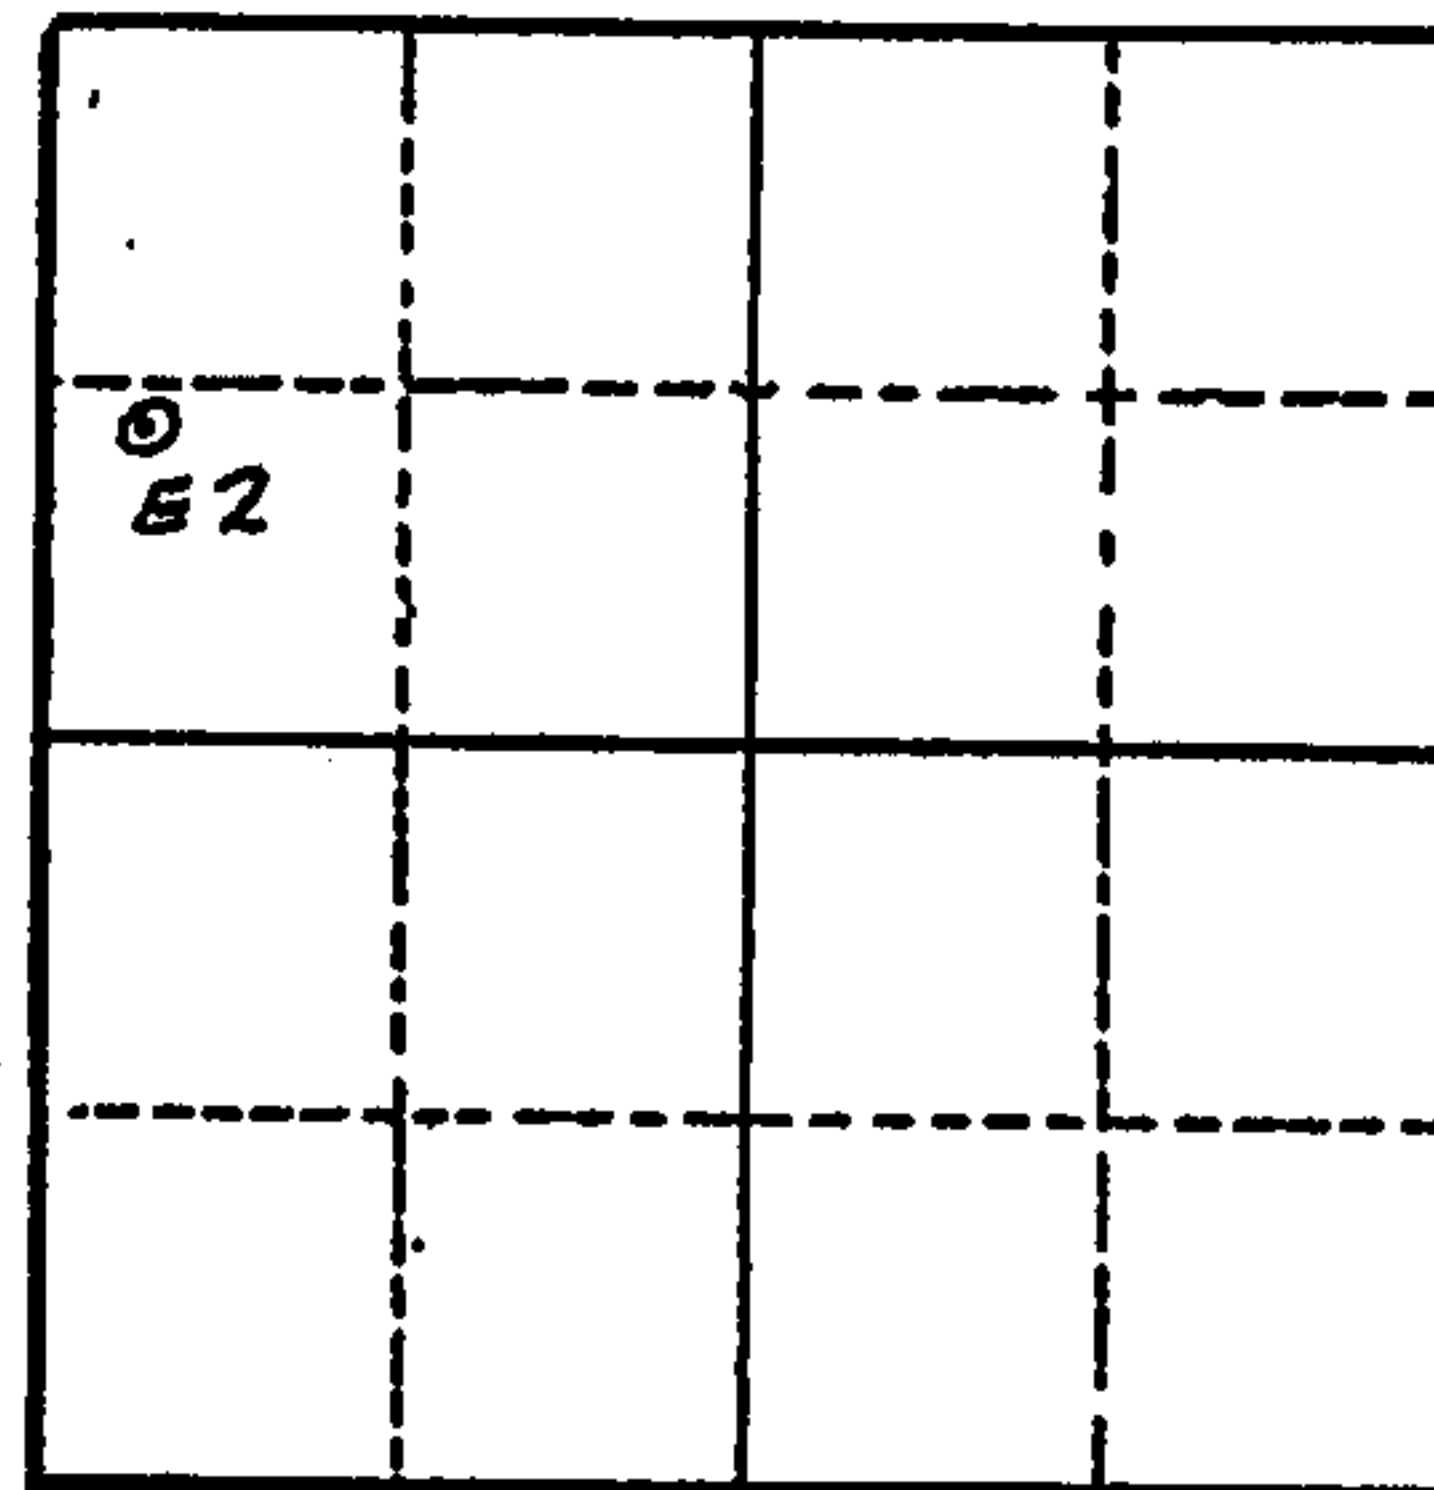

Section 32

Altitude at well

TYPE OF WELL: drilled Date Constructed

Depth drilled 225 Depth cased 16

CASING RECORD: 14 inch, set to 16 ft.

FINISH: Open hole below 16 ft.

AQUIFERS: Rock from 197 to 225 ft.

WATER LEVEL:

PUMPING EQUIPMENT: Type H.P.
Capacity G.P.M.

WELL TESTS:

Drawdown 21 ft. after 12 hours pumping 800 G.P.M.

Drawdown 40 ft. after 3 hours pumping 1800 G.P.M.

USE OF WATER Irrigation 30 acres Temp. °F. 19

SOURCE OF INFORMATION

DRILLER or DIGGER

ADDITIONAL DATA:

Log Water Level Measurements Chemical Analysis Aquifer Test

REMARKS: Drilled to 197, later deepened to 225 ft. by S. M. Munnerlyn, Aug. 1955
Permit 512