

STATE ENGINEER  
Salem, Oregon

OBSERVATION WELL  
Well Record

STATE WELL NO. 26/15-33G(1)  
COUNTY Lake  
APPLICATION NO. U-773

Lake  
480

OWNER: Merritt Parks

MAILING ADDRESS:


LOCATION OF WELL: Owner's No.

CITY AND STATE:

Fort Rock, Oregon

SW 1/4 NE 1/4 Sec. 33 T. 26 N. S., R. 15 E. W.M.

Bearing and distance from section or subdivision corner S. 44 E. 1826.7 ft. from N 1/4 cor. Sec. 33.

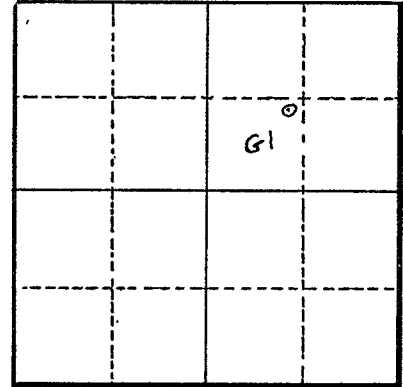

Section 33

Altitude at well

TYPE OF WELL: Date Constructed

Depth drilled 250' Depth cased

CASING RECORD:

FINISH:

AQUIFERS:

WATER LEVEL:

25.39' (7-11-62)

PUMPING EQUIPMENT: Type H.P.  
Capacity G.P.M.

WELL TESTS:

Drawdown ft. after hours G.P.M.

Drawdown ft. after hours G.P.M.

USE OF WATER Irrigation 156 acres Temp. °F., 19

SOURCE OF INFORMATION

DRILLER or DIGGER

ADDITIONAL DATA:

Log Water Level Measurements Chemical Analysis Aquifer Test

REMARKS: Permit U-690