

**Instructions for completing this report are on the last page of this form.**

WELL NO.

Address 811 SW 6th  
City Ptld State OR Zip \_\_\_\_\_

☒ New construction      ☐ Alteration (Repair/Recondition)  
☐ Conversion      ☐ Deepening      ☐ Abandonment

☐ Rotary Air      ☐ Rotary Mud      ☐ Cable  
☒ Hollow Stem Auger      ☐ Other \_\_\_\_\_

Special Standards ☒ Yes ☐ No Depth of completed well 32 ft.

☐ Pump      ☐ Bailer      ☐ Air      ☐ Flowing Artesian

Permeability \_\_\_\_\_ Yield \_\_\_\_\_ GPM \_\_\_\_\_

Conductivity \_\_\_\_\_ PH \_\_\_\_\_

Temperature of water 53 °F Depth artesian flow found \_\_\_\_\_ ft.

Was water analysis done? ☒ Yes ☐ No

By whom? P.T.I.

Depth of strata to be analyzed. From \_\_\_\_\_ ft. to \_\_\_\_\_ ft.

Remarks:

Name of supervising Geologist/Engineer DAVID LIVERMORE

Well Location: County DAKE HARNEY LAKE

Township 30 (N or S) Range 23 (E or W) Section 18

1. NW 1/4 of NW 1/4 of above section.

2. Either Street address of well location

## ALKALI LAKE OR

or Tax lot number of well location

29 Ft. below land surface. Date 9-28-94  
Artesian Pressure lb/sq. in. Date \_\_\_\_\_

Depth at which water was first found Not Notice D

<b>From</b>	<b>To</b>	<b>Est. Flow Rate</b>	<b>SWL</b>

## Ground elevation

[illegible]

Date started 9-29-94 Completed 9-29-94

**(unbonded) Monitor Well Constructor Certification:**

I certify that the work I performed on the construction, alteration, or abandonment of this well is in compliance with Oregon well construction standards. Materials used and information reported above are true to the best knowledge and belief. 1 1 MWC Number 100

Signed: David Abernathy

MWC Number 10025

Date 9-28-94

**(bonded) Monitor Well Constructor Certification:**

I accept responsibility for the construction, alteration, or abandonment work performed on this well during the construction dates reported above. All work performed during this time is in compliance with Oregon well construction standards. This report is true to the best of my knowledge and belief.

MWC Number

Signed [Signature]

Date 10/26/94

005/ 23E/1266


RECEIVED

OCT 31 1994

WATER RESOURCES DEPT.  
SALEM, OREGON

Alkali  
Lake

Nuclear  
Waste  
Traces

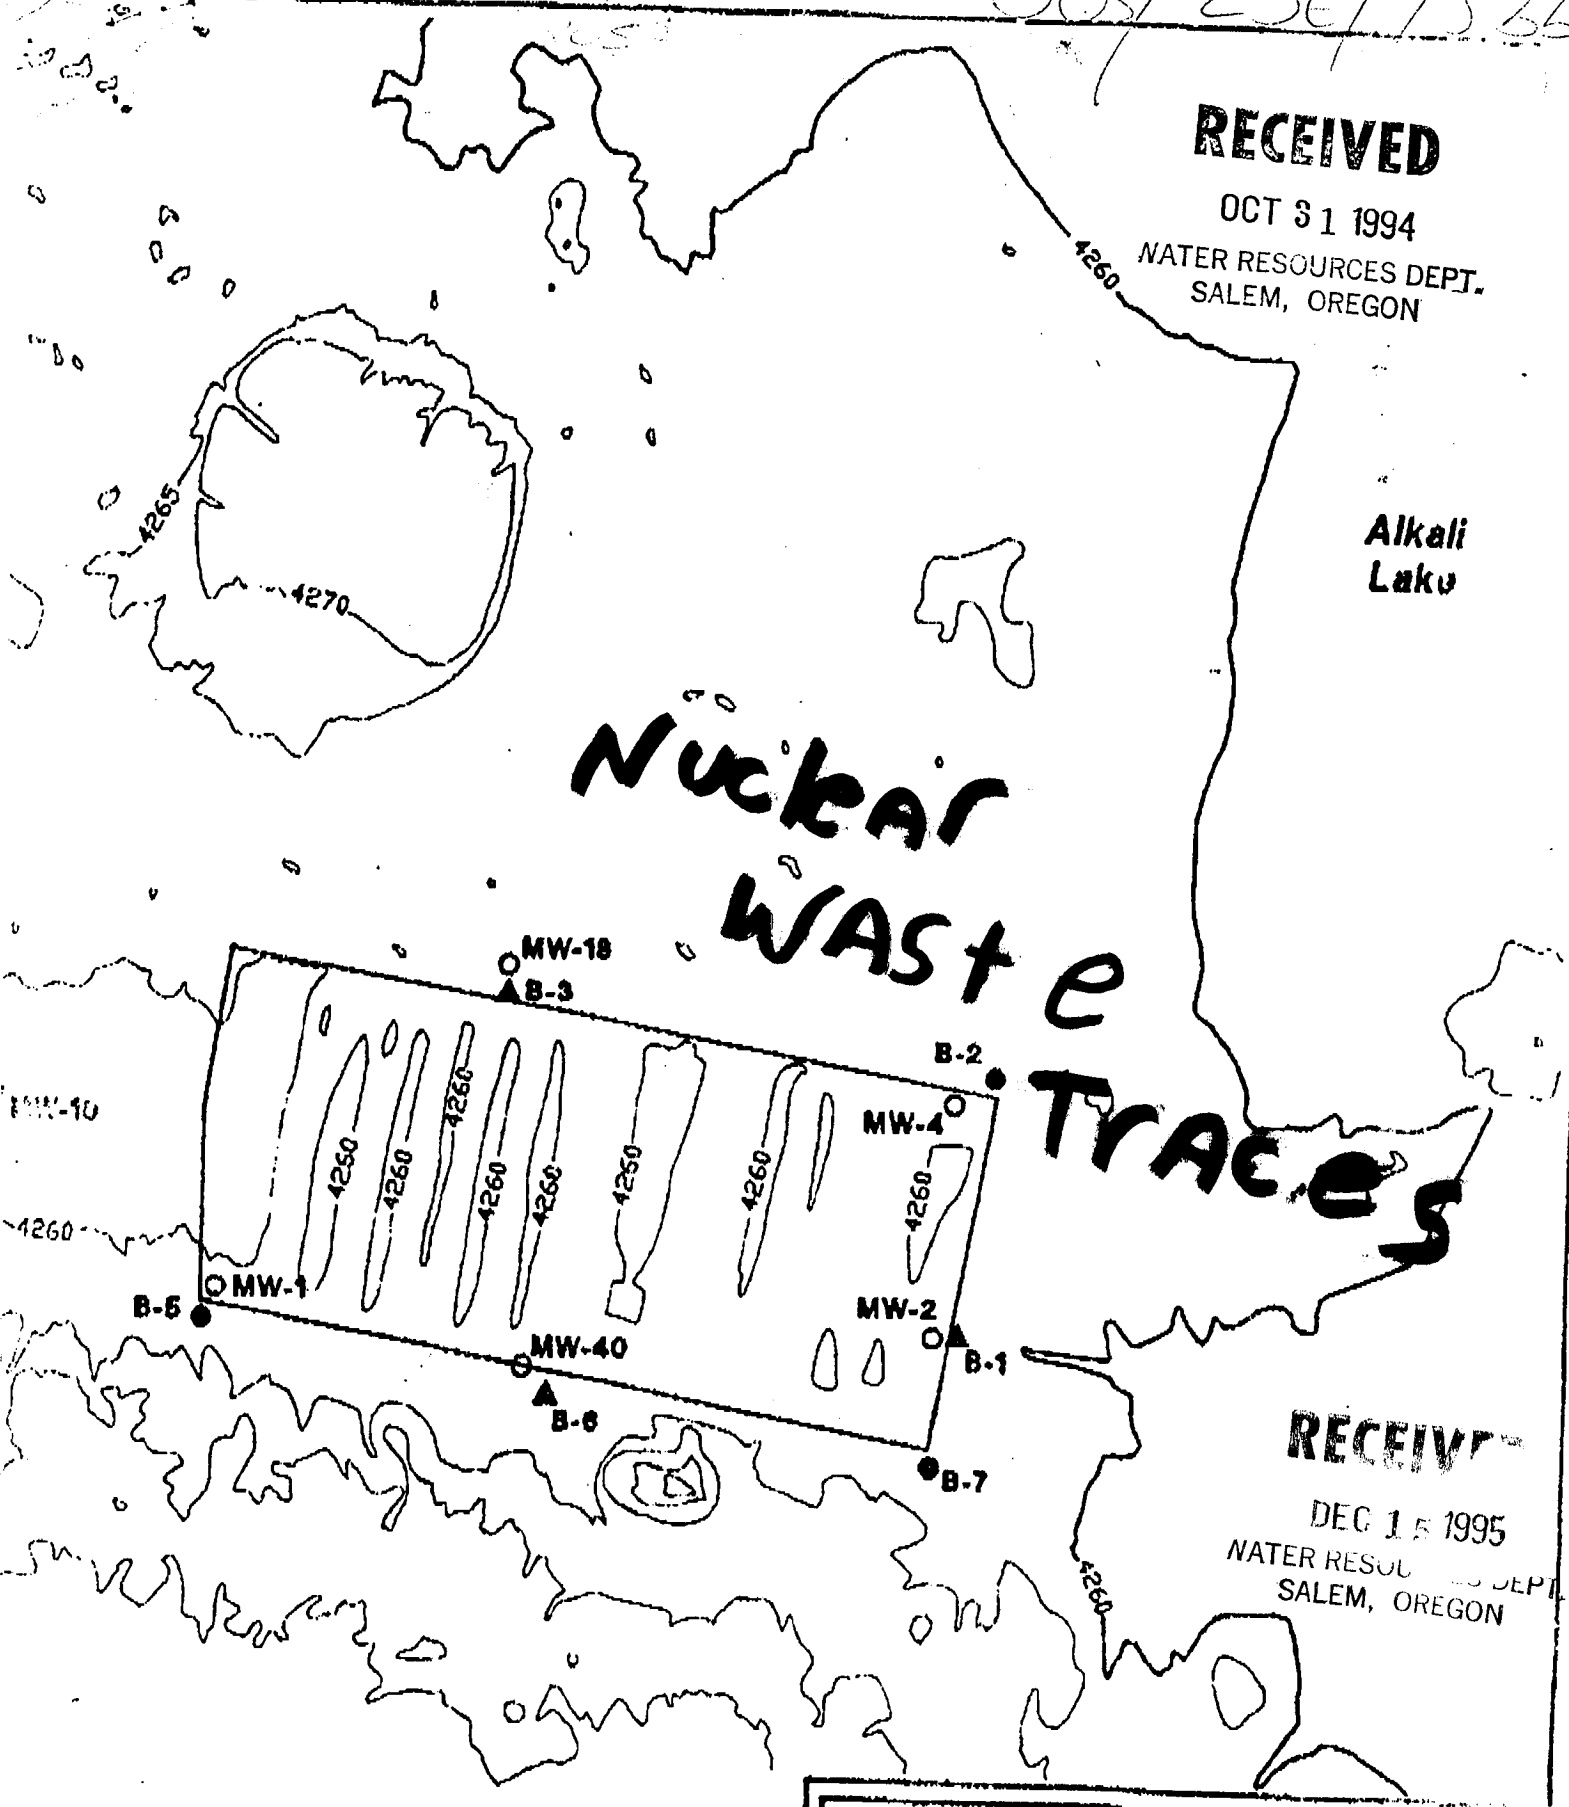

RECEIVED

DEC 15 1995

WATER RESOURCES DEPT.  
SALEM, OREGON



0 125 250 feet

Figure A-2. Location of wells and boreholes.