

005/23E/13.66

RECEIVED

OCT 31 1994

WATER RESOURCES DEPT.
SALEM, OREGON


Alkali
Lake

Nuclear
Waste
Traces

RECEIVED

DEC 15 1995

WATER RESOURCES DEPT.
SALEM, OREGON

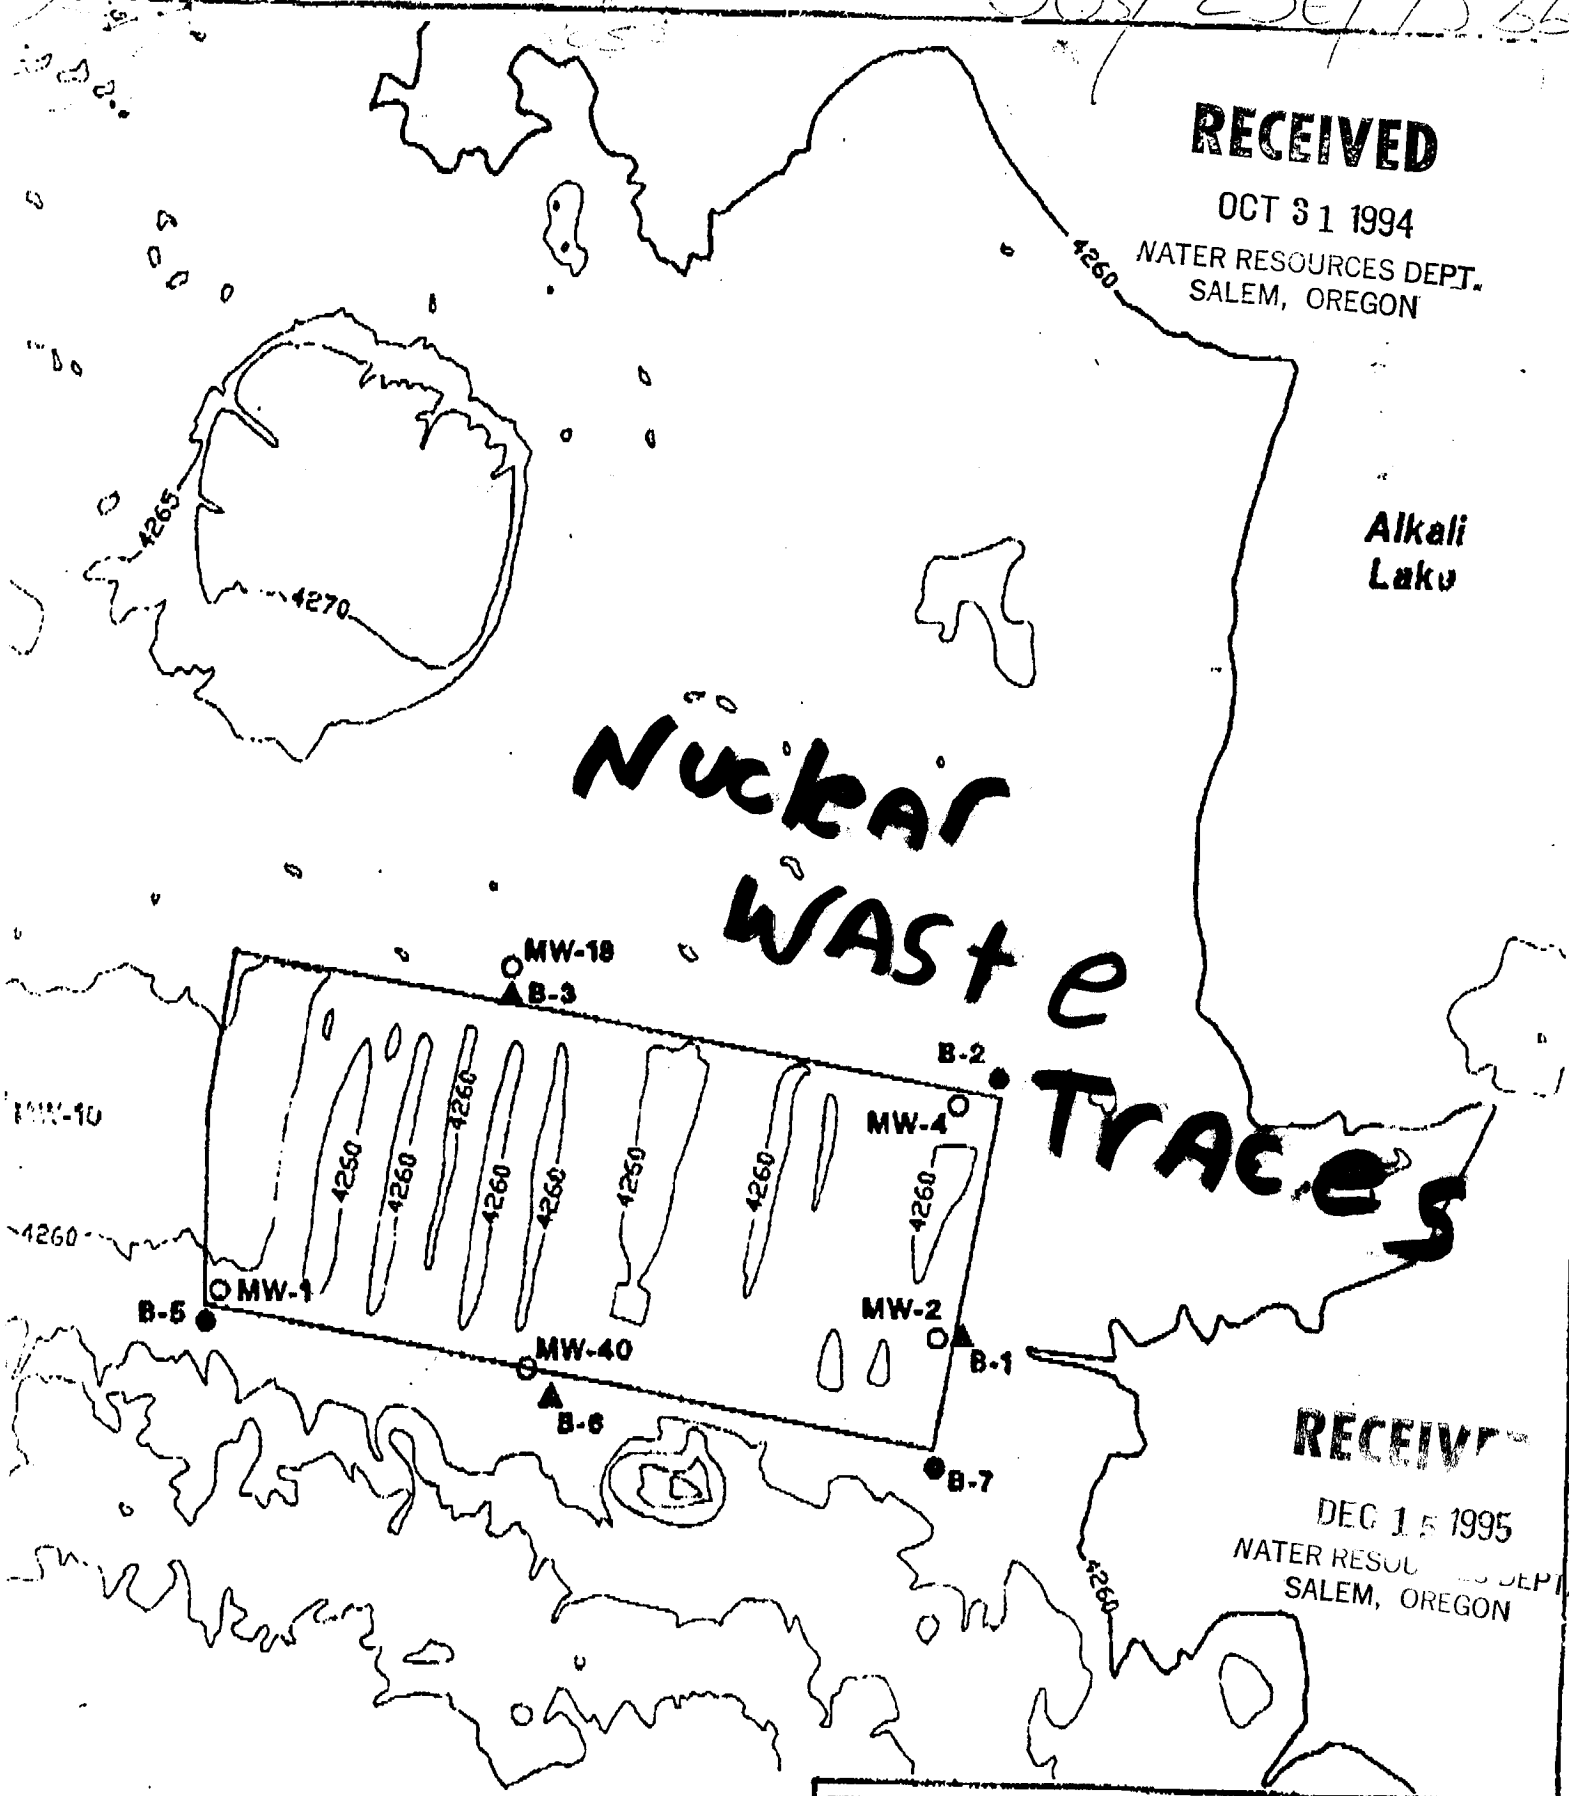

0 125 250 feet

Figure A-2. Location of wells and boreholes.