

WELL NO.

State DC Zip _____

Signature: [Signature] MWC Number 1026194
Date 10/26/94
SECOND COPY-CONSTRUCTOR THIRD COPY-CUSTOMER

503/23E/15.66


RECEIVED

OCT 31 1994

WATER RESOURCES DEPT.
SALEM, OREGON

**Alkali
Lake**

**Nuclear
Waste
Traces**

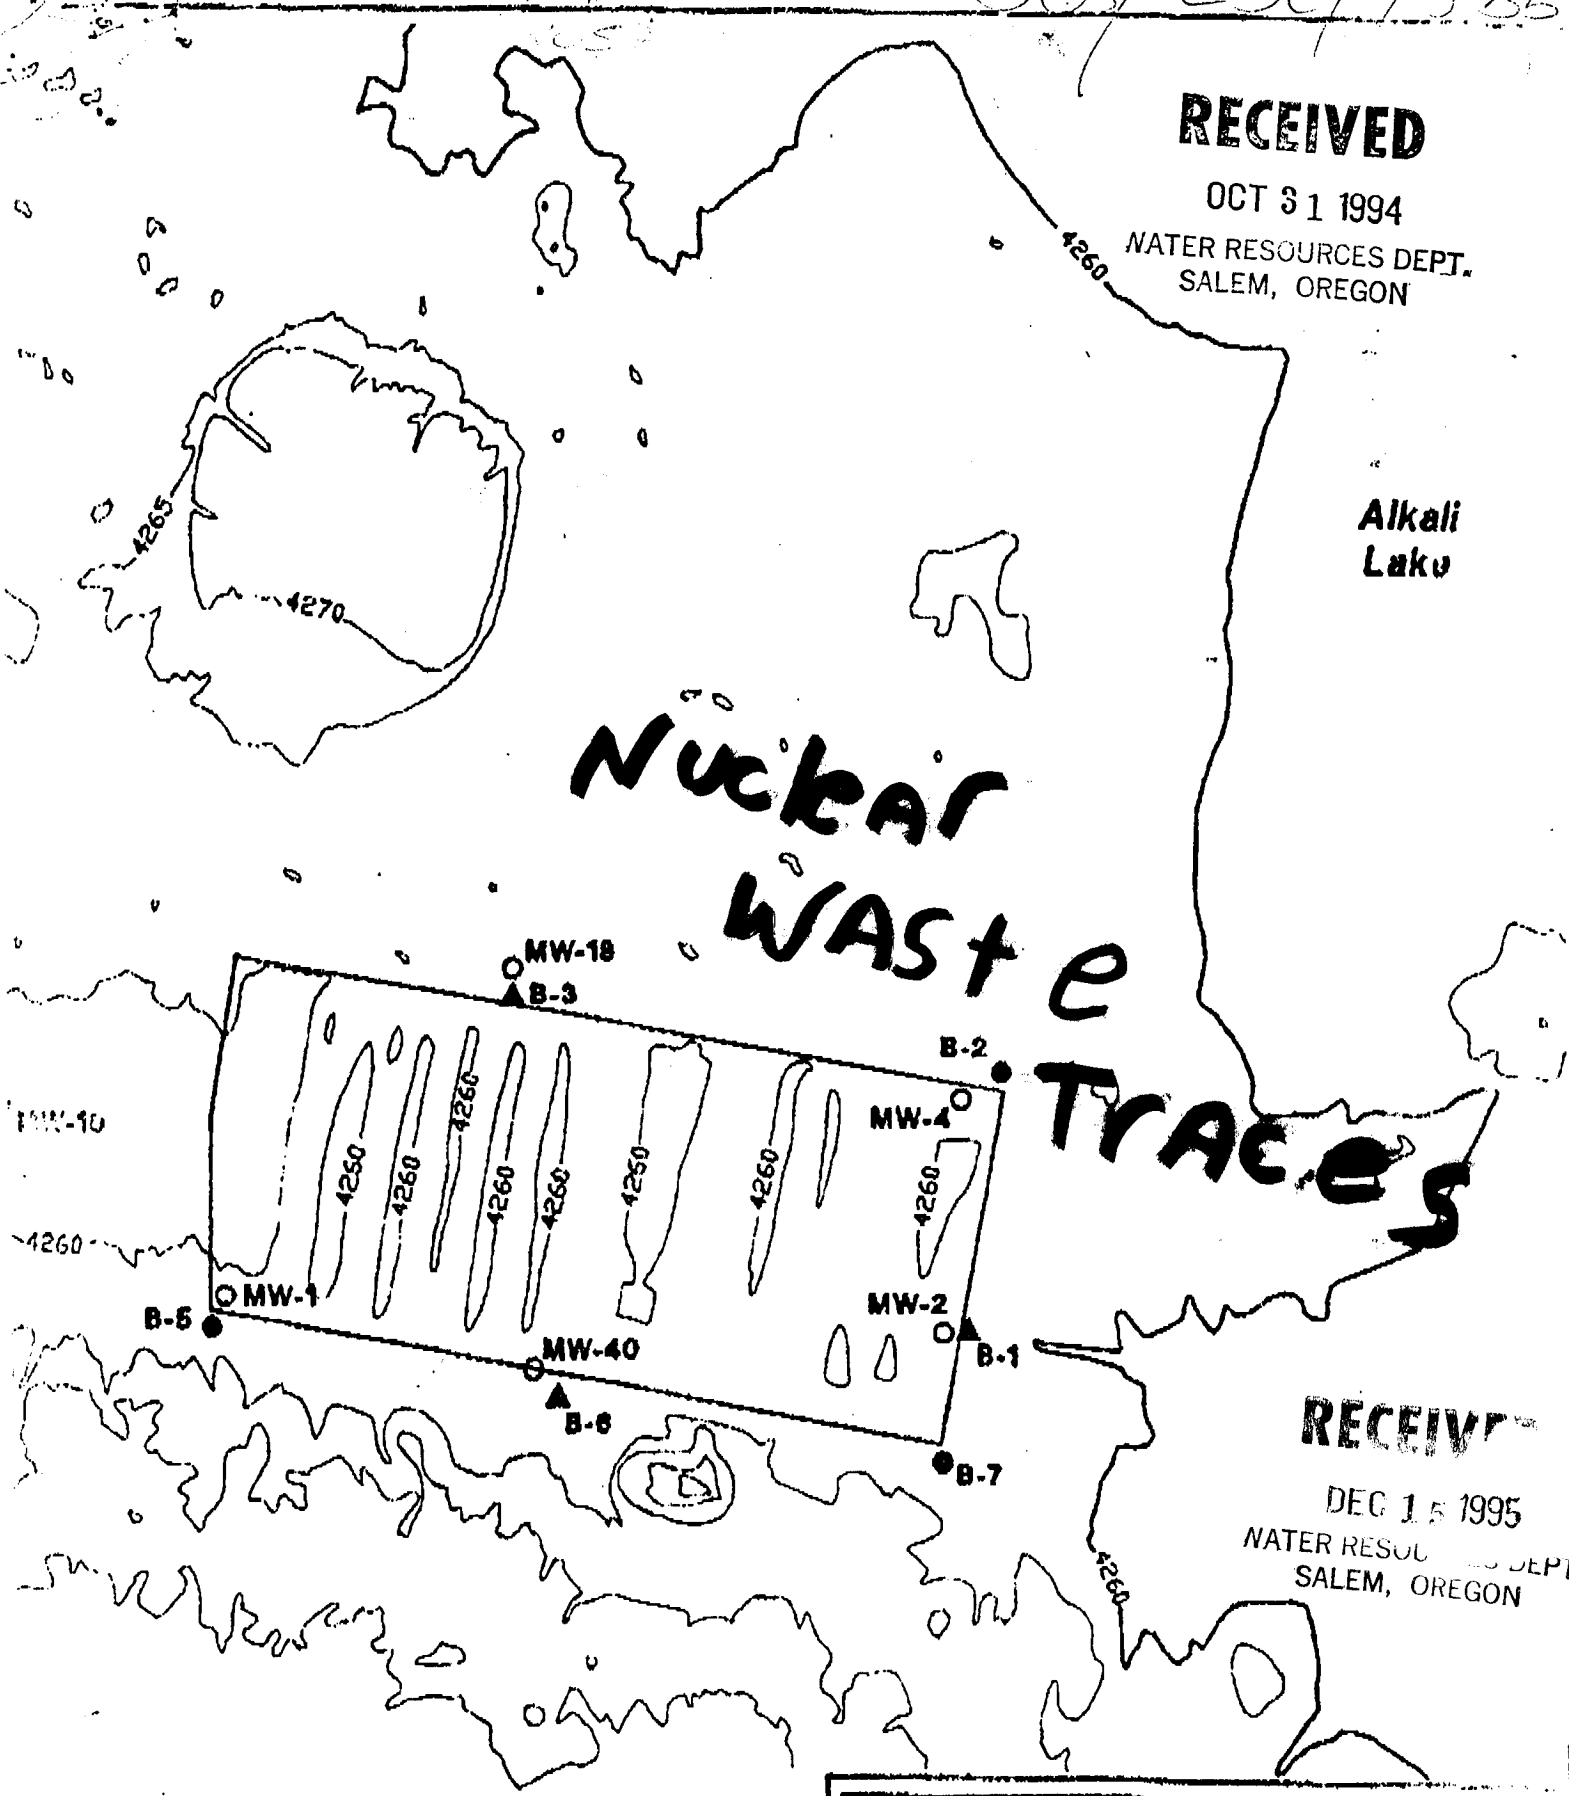

RECEIVED

DEC 15 1995

WATER RESOURCES DEPT.
SALEM, OREGON



0 125 250 feet

Figure A-2. Location of wells and boreholes.