

**STATE OF OREGON  
WATER SUPPLY WELL REPORT**

(as required by ORS 537.765)

WELL I.D. # L 57810

START CARD # 162632

Instructions for completing this report are on the last page of this form. **LAKE51575**

**(1) LAND OWNER:**  
Name Row Elder Well Number \_\_\_\_\_  
Address 29306 ABERT Rim Rd  
City Lakeview State OR Zip 97630

**(2) TYPE OF WORK:**  
 New Well  Deepening  Alteration (repair/recondition)  Abandonment

**(3) DRILL METHOD:**  
 Rotary Air  Rotary Mud  Cable  Auger  
 Other \_\_\_\_\_

**(4) PROPOSED USE:**  
 Domestic  Community  Industrial  Irrigation  
 Thermal  Injection  Livestock  Other \_\_\_\_\_

**(5) BORE HOLE CONSTRUCTION:**  
Special Construction approval  Yes  No Depth of Completed Well 640 ft.  
Explosives used  Yes  No Type \_\_\_\_\_ Amount \_\_\_\_\_

HOLE			SEAL			Sacks or pounds
Diameter	From	To	Material	From	To	
8"	590	640				

How was seal placed: Method  A  B  C  D  E  
 Other \_\_\_\_\_

Backfill placed from \_\_\_\_\_ ft. to \_\_\_\_\_ ft. Material \_\_\_\_\_  
Gravel placed from \_\_\_\_\_ ft. to \_\_\_\_\_ ft. Size of gravel \_\_\_\_\_

**(6) CASING/LINER:**

Diameter	From	To	Gauge	Steel	Plastic	Welded	Threaded
Casing:				<input type="checkbox"/>	<input type="checkbox"/>	<input type="checkbox"/>	<input type="checkbox"/>
				<input type="checkbox"/>	<input type="checkbox"/>	<input type="checkbox"/>	<input type="checkbox"/>
				<input type="checkbox"/>	<input type="checkbox"/>	<input type="checkbox"/>	<input type="checkbox"/>
				<input type="checkbox"/>	<input type="checkbox"/>	<input type="checkbox"/>	<input type="checkbox"/>
Liner:				<input type="checkbox"/>	<input type="checkbox"/>	<input type="checkbox"/>	<input type="checkbox"/>
				<input type="checkbox"/>	<input type="checkbox"/>	<input type="checkbox"/>	<input type="checkbox"/>

Drive Shoe used  Inside  Outside  None  
Final location of shoe(s) \_\_\_\_\_

**(7) PERFORATIONS/SCREENS:**

Perforations Method AIR PERFORATION  
 Screens Type \_\_\_\_\_ Material \_\_\_\_\_


From	To	Slot size	Number	Tele/pipe Diameter	Tele/pipe size	Casing	Liner
150	240	1/8x5	100			<input type="checkbox"/>	<input checked="" type="checkbox"/>

**(8) WELL TESTS: Minimum testing time is 1 hour**

Pump  Bailer  Air  Artesian

Yield gal/min	Drawdown	Drill stem at	Flowing Time
600-700		640	Dr.

Temperature of water \_\_\_\_\_ Depth Artesian Flow Found \_\_\_\_\_  
Was a water analysis done?  Yes  No By whom \_\_\_\_\_  
Did any strata contain water not suitable for intended use?  Too little  
 Salty  Muddy  Odor  Colored  Other \_\_\_\_\_  
Depth of strata: \_\_\_\_\_

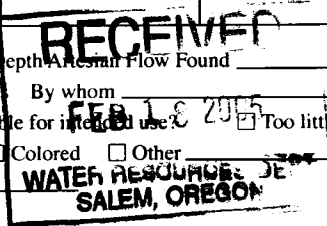

**(9) LOCATION OF WELL by legal description:**  
County Lake Latitude \_\_\_\_\_ Longitude \_\_\_\_\_  
Township 36 N or S Range 21 E or W. WM.  
Section 5 NW 1/4 SE 1/4  
Tax Lot 100 Lot \_\_\_\_\_ Block \_\_\_\_\_ Subdivision \_\_\_\_\_  
Street Address of Well (or nearest address) 29306 ABERT Rim Rd Lakeview OR 97630

**(10) STATIC WATER LEVEL:**  
10 ft. below land surface. Date 7-21-04  
Artesian pressure \_\_\_\_\_ lb. per square inch Date \_\_\_\_\_

**(11) WATER BEARING ZONES:**

Depth at which water was first found \_\_\_\_\_

From	To	Estimated Flow Rate	SWL
None			

**(12) WELL LOG:**  
Ground Elevation \_\_\_\_\_

Material	From	To	SWL
SOFT BROWN CLAY	580	615	
BROWN SAND	615	640	
# 1 Perforation 12" Liner from 150-240 with AIR PERFORAT.			

Date started 7-21-04 Completed 8-1-04

**(unbonded) Water Well Constructor Certification:**  
I certify that the work I performed on the construction, alteration, or abandonment of this well is in compliance with Oregon water supply well construction standards. Materials used and information reported above are true to the best of my knowledge and belief.  
WVC Number \_\_\_\_\_  
Signed \_\_\_\_\_ Date \_\_\_\_\_

**(bonded) Water Well Constructor Certification:**  
I accept responsibility for the construction, alteration, or abandonment work performed on this well during the construction dates reported above. All work performed during this time is in compliance with Oregon water supply well construction standards. This report is true to the best of my knowledge and belief.  
WVC Number 1654  
Signed [Signature] Date 8-24-04