

(1) OWNER 05 11
ROD HOGLAN
PO BOX 985
LAKEVIEW OR 97630

(2) TYPE OF WORK : NEW WELL

(3) DRILL METHOD : ROTARY MUD

(4) PROPOSED USE: Domestic

(5) BORE HOLE CONSTRUCTION:

Special Construction Approval NO Depth of Completed Well 119 ft.

Explosives used NO Type Amount

HOLE		SEAL		AMOUNT	
Diameter	From To	Material	From To	Sacks	
10"	0 120	BENTONITE	0 43	20	

How was seal Placed POURED DRY

Backfill placed from ft. to ft. Material

Gravel placed from 43 ft. to 120 ft. Size of Gravel #6

(6) CASING / LINER:

Dia.	From To	Gage	Material
CASING	5" +1 119	SDR21	PLASTIC

Final location of shoe (s) CAP @ 119'

(7) PERFORATIONS / SCREENS:

METHOD	TYPE	MATERIAL
FACTORY		PVC

From To	Slot size	Number	Dia.	Tele / pipe size
99 119	032	3680		5"

(8) WELL TESTS:

Minimum testing time is 1 hour
TESTING METHOD AIR
Yield GPM Drawdown Drill stem at Time
60 60' 1 HOUR

Temperature of Water 57 F° Depth Artesian Flow Found

Was a water analysis done? NO By whom

Did any strata contain water not suitable for intended use? No

(9) LOCATION OF WELL by legal description :

County LAKE Latitude Longitude
Township 39 S Range 19 E
Section 13 NW 1/4 NE 1/4
Tax Lot 601 Lot Block Subdivision
Street Address of Well (or nearest address)
7398 HWY 140E LAKEVIEW OR

(10) STATIC WATER LEVEL:

17 ft. below land surface Date April 22, 2005
Artesian pressure Date

(11) WATER BEARING ZONES :

Depth at which water was first found	From To	Estimated Flow Rate	SWL
66'	66 120	60 GPM	17

(12) WELL LOG:

	Ground Elevation	FROM	TO	SWL
SOIL		0	2	
BROWN CLAY		2	8	
BROWN CLAY & BROWN SAND		8	9	
BROWN CLAY		9	26	
BROWN CLAY & BROWN SAND		26	32	
BLUE CLAY		32	44	
GREY CLAYw/BROWN & GREY		44		
SANDSTONE			66	
GREY CLAYw/ GREY SAND		66	95	17
BLUE CLAY w/ BLACK SAND		95	120	17

RECEIVED

APR 28 2005

WATER RESOURCES DEPT
SALEM, OREGON

Date started April 21, 2005

Completed April 22, 2005

(Unbonded) Water Well Constructor Certification: I certify that the work I performed on the construction, alteration, or abandonment of this well is in compliance with Oregon well construction standards. Materials used and information reported above are true to my best knowledge and belief.

M. L. W. DATE 4-27-05 WWC # 1452

(Bonded) Water Well Constructor Certification: I accept responsibility for the construction alteration or abandonment work performed on this well during the construction dates reported above. All work performed during this time is in compliance with Oregon well construction standards. This report is true to the best of my knowledge and belief.


[Signature] DATE 4-27-05 WWC # 693

39 19 13

SECTION 13 T.39S. R.19E. W.M.
LAKE COUNTY
7-19-13

THIS MAP WAS PREPARED FOR
ASSESSMENT PURPOSES ONLY

SEE MAP 30 11

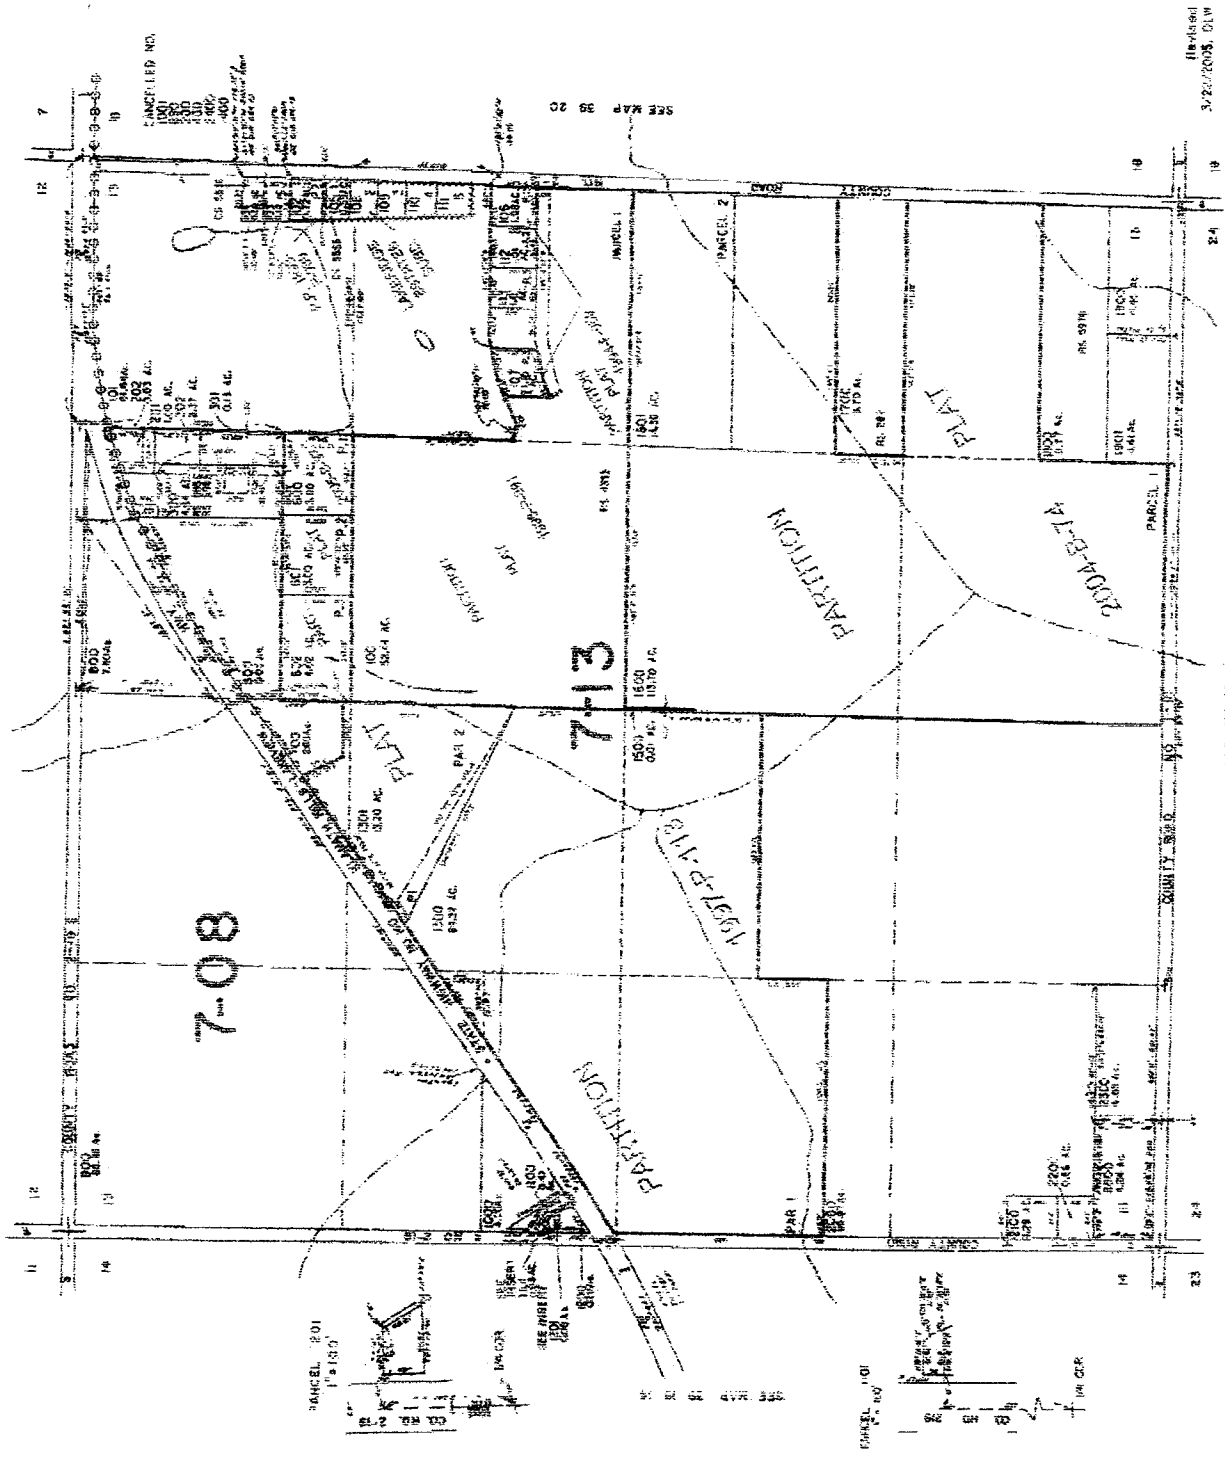

Revised
3/20/2005, OLW

39 19 13

SEE MAP 35 19