

(1) OWNER 06 01
JOHN ALBERTSON
14377 ALBERTSON RD
LAKEVIEW OR 97630

(2) TYPE OF WORK : NEW WELL

(3) DRILL METHOD : ROTARY MUD

(4) PROPOSED USE: Irrigation

(5) BORE HOLE CONSTRUCTION:

Special Construction Approval NO Depth of Completed Well 1510 ft.
Explosives used NO Type Amount

HOLE		SEAL		AMOUNT	
Diameter	From To	Material	From To	Sacks	
17-1/2"	0 215	CEMENT	0 215	156	
12"	215 1510				

How was seal Placed C

Backfill placed from ft. to ft. Material

Gravel placed from 215 ft. to 1510 ft. Size of Gravel #6

(6) CASING / LINER:

	Dia.	From	To	Gage	Material
CASING	12"	+1	215	250	STEEL / WELDED
LINER	8"	200	1510	188	STEEL / WELDED

Final location of shoe (s)

(7) PERFORATIONS / SCREENS:

Perforations
METHOD TYPE MATERIAL
FACTORY STEEL/LINER

From	To	Slot size	Number	Dia.	Tele / pipe size
340	1180	060	140800	8"	

(8) WELL TESTS: Minimum testing time is 1 hour

TESTING METHOD AIR
Yield GPM Drawdown Drill stem at Time
600 40' 1 HOUR

Temperature of Water 64 F Depth Artesian Flow Found

Was a water analysis done? NO By whom

Did any strata contain water not suitable for intended use? Yes

Surface Water, 12'-39'

(9) LOCATION OF WELL by legal description :

County LAKE Latitude Longitude
Township 40 S Range 19 E
Section 29 NW 1/4 SE 1/4
Tax Lot 900 Lot Block Subdivision
Street Address of Well (or nearest address)
14377 ALBERTSON RD. LAKEVIEW OR

(10) STATIC WATER LEVEL:

0 ft. below land surface Date March 9, 2006
Artesian pressure Less than 1 psi Date March 9, 2006

(11) WATER BEARING ZONES :

Depth at which water was first found 12		Estimated Flow Rate	SWL
From	To		
12	39	20 gpm	7
284	1175	1500 gpm	0

(12) WELL LOG:

	Ground Elevation		
	FROM	TO	SWL
SOIL	0	2	
BROWN SANDY CLAY	2	5	
BROWN CLAY	5	12	
COARSE GREY SAND	12	16	7
GREY SAND & 1/2" GRAVEL	16	39	7
BLUE CLAY	39	52	
COARSE SAND	52	56	
BLUE CLAY & LAYERS OF SAND	56	188	
BLUE CLAY	188	284	
BLUE CLAY w/LAYERS OF BLACKSAND	284	462	0
BLUE CLAY w/LAYERS OF WHITE	462		
PUMICE		510	0
BLUE CLAY w/LAYERS OF BLACKSAND	510	1175	0
BLUE CLAY w/SOME BLACK SAND	1175	1475	
BLUE CLAY	1475	1479	
HARD GREY CLAY	1479	1510	


Date started December 13, 2004 Completed March 9, 2006

(Unbonded) Water Well Constructor Certification: I certify that the work I performed on the construction, alteration, or abandonment of this well is in compliance with Oregon well construction standards. Materials used and information reported above are true to my best knowledge and belief.

[Signature] DATE 4-3-06 WWC # 1452

(Bonded) Water Well Constructor Certification: I accept responsibility for the construction alteration or abandonment work performed on this well during the construction dates reported above. All work performed during this time is in compliance with Oregon well construction standards. This report is true to the best of my knowledge and belief.

[Signature] DATE 3-31-06 WWC # 693

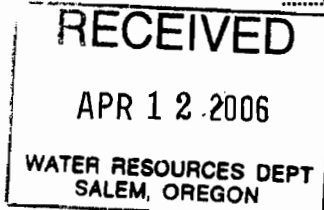

40 19 29

THIS MAP WAS PREPARED FOR
ASSESSMENT PURPOSE ONLY

 $r^* = 400^\circ$ 

40 19 29