

STATE OF OREGON
 WATER SUPPLY WELL REPORT
 (as required by ORS 537.765 & OAR 690-205-0210)

LAKE 52507
 2/26/2014

WELL I.D. LABEL# L 109634
 START CARD # 1019627
 ORIGINAL LOG #

(1) LAND OWNER Owner Well I.D.
 First Name MR. GEORGE Last Name JAS
 Company
 Address 93939 JASKA LANE
 City LAKEVIEW State OR Zip 97630

(2) TYPE OF WORK New Well Deepening Conversion
 Alteration (complete 2a & 10) Abandonment (complete 5a)

(2a) PRE-ALTERATION
 Dia + From To Gauge Stl Plstc Wld Thrd
 Casing: Material From To Amt sacks/lbs
 Seal: Material From To Amt sacks/lbs

(3) DRILL METHOD
 Rotary Air Rotary Mud Cable Auger Cable Mud
 Reverse Rotary Other

(4) PROPOSED USE Domestic Irrigation Community
 Industrial/ Commercial Livestock Dewatering
 Thermal Injection Other

(5) BORE HOLE CONSTRUCTION Special Standard (Attach copy)
 Depth of Completed Well 380.00 ft.

BORE HOLE			SEAL			sacks/lbs	
Dia	From	To	Material	From	To	Amt	lbs
20	0	101	Cement	0	101	110	S
15.5	101	380					

How was seal placed: Method A B C D E
 Other
 Backfill placed from ft. to ft. Material
 Filter pack from 5 ft. to 380 ft. Material 3/8 Size pea gravel
 Explosives used: Yes Type Amount

(5a) ABANDONMENT USING UNHYDRATED BENTONITE
 Proposed Amount Actual Amount

(6) CASING/LINER
 Casing Liner Dia + From To Gauge Stl Plstc Wld Thrd
 Shoe Inside Outside Other Location of shoe(s)
 Temp casing Yes Dia From To

(7) PERFORATIONS/SCREENS
 Perforations Method Factory Saw
 Screens Type Material

Perf/ Screen	Casing/ Liner	Screen Dia	From	To	Scrnl/ slot width	Slot length	# of slots	Tele/ pipe size
Perf	Liner	10	100	200	.095	3	5200	
Perf	Liner	10	240	380	.095	3	2080	

(8) WELL TESTS: Minimum testing time is 1 hour
 Pump Bailer Air Flowing Artesian

Yield gal/min	Drawdown	Drill stem/Pump depth	Duration (hr)
350	21	147	24

 Temperature 71 °F Lab analysis Yes By
 Water quality concerns? Yes (describe below) TDS amount

From	To	Description	Amount	Units

(9) LOCATION OF WELL (legal description)
 County LAKE Twp 39.00 S N/S Range 19.00 E E/W WM
 Sec 1 NW 1/4 of the SW 1/4 Tax Lot 500
 Tax Map Number Lot
 Lat " or " DMS or DD
 Long " or " DMS or DD
 Street address of well Nearest address
 93939 JASKA LANE, LAKEVIEW, OR

(10) STATIC WATER LEVEL

Existing Well / Pre-Alteration Completed Well	Date	SWL (psi)	+ SWL (ft)
	5/22/2013		15

 Flowing Artesian? Dry Hole?

WATER BEARING ZONES Depth water was first found 22'

SWL Date	From	To	Est Flow	SWL (psi)	+ SWL (ft)
4/25/2013	22	380	800		15

(11) WELL LOG Ground Elevation

Material	From	To
Brown Clay	0	15
Sandy Blue Clay	15	22
Black Sand	22	33
Brown Clay and Sand Steaks	33	98
Cemented Gravels & Brown Clay	98	115
Gravel	115	130
Finer Gravel & Sand	130	140
Brown Sand & Gravel	140	160
Coarse Sand	160	165
Coarse Sand	160	165
Blue Clay & Fine Sand Layers	165	180
Coarser Sand & Blue Clay	180	200
Fine Sand & Blue Clay	200	230
Blue Clay	230	245
Sand & Blue Clay	245	250
Sand & Wood Chunks	250	255
Sand & Blue Clay	255	265
Sand & Blue Clay with Wood Fragments	265	270
Blue Clay & Fine Sand Layers	270	290


Date Started 4/23/2013 Complete 5/22/2013

(unbonded) Water Well Constructor Certification
 I certify that the work I performed on the construction, deepening, alteration, or abandonment of this well is in compliance with Oregon water supply well construction standards. Materials used and information reported above are true to the best of my knowledge and belief.

License Number Date
 Signed

(bonded) Water Well Constructor Certification
 I accept responsibility for the construction, deepening, alteration, or abandonment work performed on this well during the construction dates reported above. All work performed during this time is in compliance with Oregon water supply well construction standards. This report is true to the best of my knowledge and belief.

License Number 1385 Date 2/26/2014
 Signed ROBERT BUCKNER (E-filed)
 Contact Info (optional)

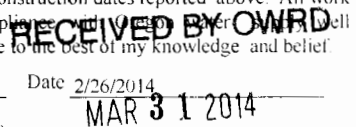

SALEM, OR

