

STATE ENGINEER  
Salem, Oregon

Lake  
61

# Well Record

STATE WELL NO. 24/18-31R(2)  
COUNTY Lake  
APPLICATION NO.

OWNER: Chewaucan Land & Cattle Co.


MAILING  
ADDRESS:

LOCATION OF WELL: Owner's No. East Sink

CITY AND  
STATE:

SE 1/4 SE 1/4 Sec. 31 T. 24 S., R. 18 E., W.M.

Bearing and distance from section or subdivision  
corner

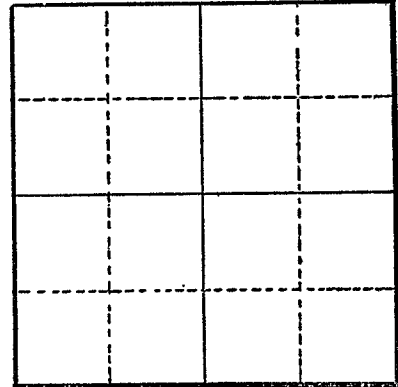

Section 31

Altitude at well 4,400 (USGS Report)

TYPE OF WELL: Drilled Date Constructed

Depth drilled 82 Depth cased 20

CASING RECORD: 4 inches

FINISH:

AQUIFERS: Fractures in rock

WATER LEVEL: 38.95 ft. below land surface, Oct. 16, 1948

PUMPING EQUIPMENT: Type Piston H.P.  
Capacity G.P.M.

WELL TESTS:  
Drawdown ft. after hours G.P.M.  
Drawdown ft. after hours G.P.M.

USE OF WATER stock Temp. °F., 19  
SOURCE OF INFORMATION USGS Report page 12

DRILLER or DIGGER

ADDITIONAL DATA:  
Log Water Level Measurements Chemical Analysis Aquifer Test

REMARKS: Hardness 195 ppm  
Chloride 18 ppm