

STATE ENGINEER  
Salem, Oregon

*Lake  
7/12*

# OBSERVATION WELL Well Record

STATE WELL NO. 27/15-2H(2)  
COUNTY Lake  
APPLICATION NO. U-426

OWNER: Owen Pitcher (L.B. IVERSON)


MAILING ADDRESS: \_\_\_\_\_

LOCATION OF WELL: Owner's No. #1

CITY AND STATE: Fort Rock, Oregon

SE 1/4 NE 1/4 Sec. 2 T. 27 S., R. 15 <sup>N.</sup> ~~W.~~ <sup>E.</sup> W.M.

Bearing and distance from section or subdivision corner S. 13° 23' W. 2538 ft. from NE cor. Sec.

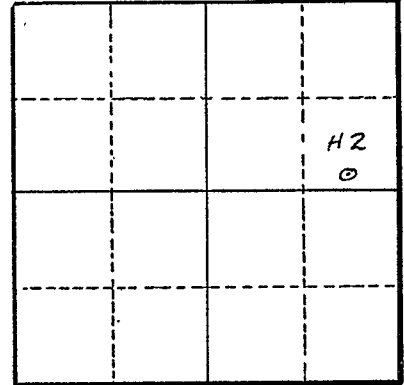

Section 2

Altitude at well \_\_\_\_\_

TYPE OF WELL: drilled Date Constructed 1950

Depth drilled 255 Depth cased 1

CASING RECORD: 18 inch

FINISH: \_\_\_\_\_

AQUIFERS: Cinders from 167 to 170 and 174 to 187 ft.

WATER LEVEL: 24 ft. below land surface, Feb. 1951

PUMPING EQUIPMENT: Type turbine H.P. \_\_\_\_\_  
Capacity \_\_\_\_\_ G.P.M.

WELL TESTS:  
Drawdown \_\_\_\_\_ ft. after \_\_\_\_\_ hours \_\_\_\_\_ G.P.M.  
Drawdown \_\_\_\_\_ ft. after \_\_\_\_\_ hours \_\_\_\_\_ G.P.M.

USE OF WATER Irrigation 80 acres Temp. \_\_\_\_\_ °F. \_\_\_\_\_, 19\_\_\_\_

SOURCE OF INFORMATION U-426

DRILLER or DIGGER Leonard Pitcher

ADDITIONAL DATA:  
Log <sup>X</sup> \_\_\_\_\_ Water Level Measurements \_\_\_\_\_ Chemical Analysis \_\_\_\_\_ Aquifer Test \_\_\_\_\_

REMARKS: Permit 394



### Water Level Record

OWNER: Queen Pitcher OWNER'S NO. \_\_\_\_\_

Description of measuring point: Top of ground at 0.00

Date	Water Level Feet (below) Land Surface	Remarks	Date	Water Level Feet (above) (below) Land Surface	Remarks
10/19/49	21.0	WSB			
2/1951	24.0	Permit			
5/23/56	20.5	WSB			
8-28-56	19.98	WSB			
10-16-56	20.17	WSB			
5-1-57	19.84	WSB			
8-20-57	19.87	WSB			
10-24-57	19.48	WSB			
4-23-58	19.30	WSB			
10-14-58	17.98	WSB			
5-12-59	40.7	Pump operating			
10-14-59	18.96	WSB			
4-27-60	18.95	JES-WSB			
5-3-61	18.58	WSB			
10-18-61	19.77	WSBERD - OIL			

REMARKS: See hydrograph