

STATE ENGINEER
Salem, Oregon

Lake
175

Well Record

STATE WELL NO. 27/15-3B(1)
COUNTY Lake
APPLICATION NO. U-784

OWNER: Clayton Mann

MAILING
ADDRESS:


LOCATION OF WELL: Owner's No. 2

CITY AND
STATE:

Fort Rock, Oregon

NW 1/4 NE 1/4 Sec. 3 T. 27 N. S, R. 15 E. W., W.M.

Bearing and distance from section or subdivision
corner

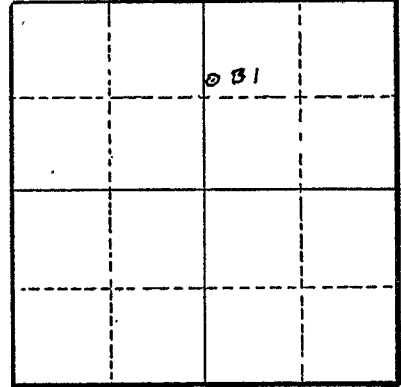

Section 3

Altitude at well

TYPE OF WELL: drilled Date Constructed Apr. 1955

Depth drilled 75 Depth cased

CASING RECORD: 18 inch

FINISH:

AQUIFERS:

WATER LEVEL: 23 ft. below land surface

PUMPING EQUIPMENT: Type turbine H.P.
Capacity 1200 G.P.M.

WELL TESTS:
Drawdown 11 ft. after hours pumping 1200 G.P.M.
Drawdown ft. after hours G.P.M.

USE OF WATER Irrigation Temp. °F., 19

SOURCE OF INFORMATION

DRILLER or DIGGER

ADDITIONAL DATA:

Log Water Level Measurements Chemical Analysis Aquifer Test

REMARKS: Permit U-710