

STATE ENGINEER
Salem, Oregon

*Lake
776*

OBSERVATION WELL Well Record

STATE WELL NO. 27/15-3J(1)
COUNTY Lake
APPLICATION NO. U-347

OWNER: Clayton Mann


MAILING ADDRESS: _____

LOCATION OF WELL: Owner's No. 1

CITY AND STATE: Fort Rock, Oregon

NE 1/4 SE 1/4 Sec. 3 T. 27 N. S., R. 15 W. E., W.M.

Bearing and distance from section or subdivision
corner N. 25° 12' W. 1666 ft. from SE cor. Sec.

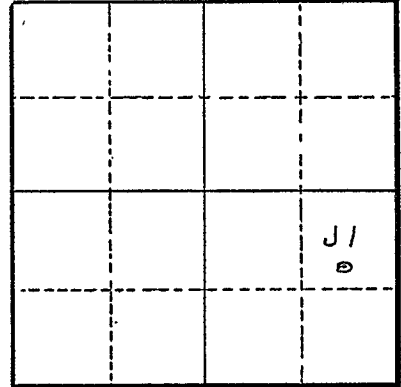

Section 3

Altitude at well _____

TYPE OF WELL: drilled Date Constructed 1947

Depth drilled 64 Depth cased _____

CASING RECORD: 12 inch

FINISH: _____

AQUIFERS: _____

WATER LEVEL: 30.78 ft. below land surface, Sept. 27, 1949

PUMPING EQUIPMENT: Type turbine H.P. _____
Capacity 1800 G.P.M.

WELL TESTS:
Drawdown _____ ft. after _____ hours _____ G.P.M.
Drawdown 4 ft. after _____ hours pumping 1800 G.P.M.

USE OF WATER Irrigation 80 acres Temp. _____ °F. _____, 19____

SOURCE OF INFORMATION U-347 USGS

DRILLER or DIGGER _____

ADDITIONAL DATA:
Log X Water Level Measurements _____ Chemical Analysis _____ Aquifer Test _____

REMARKS: Permit U-322
1956 - Well enlarged to 18 in. diameter, finished at 64 ft. New pump installed.