

STATE ENGINEER  
Salem, Oregon

*Lake  
818*

# Well Record


STATE WELL NO. 27/15-14B(1)  
COUNTY Lake  
APPLICATION NO. G-1022

OWNER: Thelma Heilmeyer MAILING ADDRESS: \_\_\_\_\_

LOCATION OF WELL: Owner's No. \_\_\_\_\_ CITY AND STATE: Fort Rock, Oregon

NW  $\frac{1}{4}$  NE  $\frac{1}{4}$  Sec. 14 T. 27 S., R. 15 W., W.M.

Bearing and distance from section or subdivision  
corner 1050' S. & 2076' W. from NE cor. Sec. 14

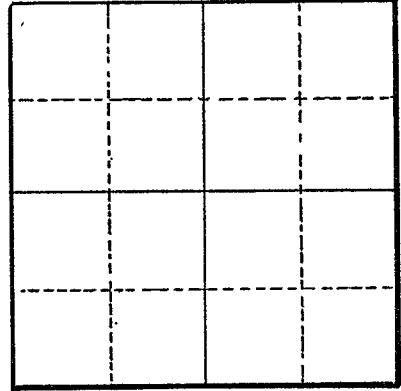

Section 14

Altitude at well 4,340

TYPE OF WELL: drilled Date Constructed \_\_\_\_\_

Depth drilled 60 Depth cased 15

CASING RECORD: 12 - 6 inch

FINISH: \_\_\_\_\_

AQUIFERS: Basalt, weathered

WATER LEVEL: 43.7

PUMPING EQUIPMENT: Type piston H.P. \_\_\_\_\_  
Capacity \_\_\_\_\_ G.P.M.

WELL TESTS:  
Drawdown \_\_\_\_\_ ft. after \_\_\_\_\_ hours \_\_\_\_\_ G.P.M.  
Drawdown \_\_\_\_\_ ft. after \_\_\_\_\_ hours \_\_\_\_\_ G.P.M.

USE OF WATER domestic & stock Temp. 54 °F. \_\_\_\_\_, 19\_\_\_\_

SOURCE OF INFORMATION \_\_\_\_\_

DRILLER or DIGGER \_\_\_\_\_

ADDITIONAL DATA:  
Log  Water Level Measurements \_\_\_\_\_ Chemical Analysis \_\_\_\_\_ Aquifer Test \_\_\_\_\_

REMARKS: Hardness 30 ppm, Chloride 13 ppm

STATE ENGINEER  
Salem, Oregon

*lake 818*

# Well Record


STATE WELL NO. 27/15-14B(2)  
COUNTY Lake  
APPLICATION NO. G-1022

OWNER: Thelma G. Heilmeyer MAILING ADDRESS: \_\_\_\_\_

LOCATION OF WELL: Owner's No. \_\_\_\_\_ CITY AND STATE: Fort Rock, Oregon

NW 1/4 NE 1/4 Sec. 14 T. 27 S., R. 15 W., W.M.

Bearing and distance from section or subdivision corner 1224' S. & 1734' W. from NE cor. Sec. 14

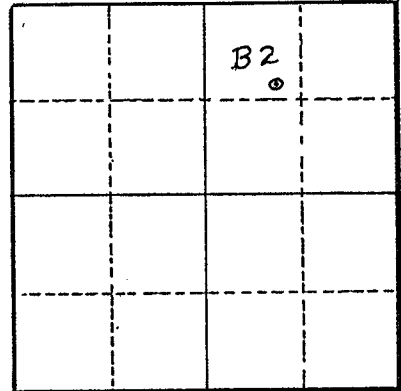

Altitude at well 4,328

TYPE OF WELL: drilled Date Constructed \_\_\_\_\_

Depth drilled 65 Depth cased 8

Section 14

CASING RECORD: 12 - 8 inch

FINISH: \_\_\_\_\_

AQUIFERS: "Cinders", red

WATER LEVEL: 32

PUMPING EQUIPMENT: Type turbine - 600 gpm H.P. \_\_\_\_\_  
Capacity \_\_\_\_\_ G.P.M.

WELL TESTS:  
Drawdown \_\_\_\_\_ ft. after \_\_\_\_\_ hours \_\_\_\_\_ G.P.M.  
Drawdown \_\_\_\_\_ ft. after \_\_\_\_\_ hours \_\_\_\_\_ G.P.M.

USE OF WATER irrigation Temp. 54 °F. \_\_\_\_\_, 19 \_\_\_\_\_

SOURCE OF INFORMATION \_\_\_\_\_  
DRILLER or DIGGER \_\_\_\_\_

ADDITIONAL DATA:  
Log X Water Level Measurements \_\_\_\_\_ Chemical Analysis \_\_\_\_\_ Aquifer Test \_\_\_\_\_

REMARKS: Hardness 30 ppm, Chloride 12 ppm  
Owner reports pump has operated steadily for 14 days at 600 gpm with steady yield