

STATE ENGINEER
Salem, Oregon

OBSERVATION WELL
Well Record

STATE WELL NO. 27/15-24M(2)
COUNTY Lake
APPLICATION NO.

OWNER: Bowen (GAP RANCH)

MAILING
ADDRESS: GAP Ranch

LOCATION OF WELL: Owner's No. 3

CITY AND
STATE: Fort Rock, Oregon

NW 1/4 SW 1/4 Sec. 24 T. 27 N. S. R. 15 E. W., W.M.


Bearing and distance from section or subdivision
corner

Altitude at well

TYPE OF WELL: Drilled Date Constructed

Depth drilled Depth cased

CASING RECORD: 12 inch casing

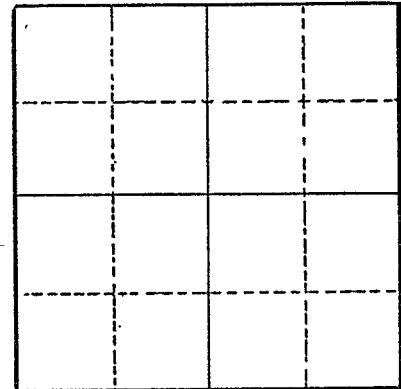

Section

FINISH:

AQUIFERS:

WATER LEVEL: 21.96 feet below land surface 5/3/61

PUMPING EQUIPMENT: Type none H.P.
Capacity G.P.M.

WELL TESTS:
Drawdown ft. after hours G.P.M.
Drawdown ft. after hours G.P.M.

USE OF WATER none Temp. °F., 19

SOURCE OF INFORMATION field

DRILLER or DIGGER ?

ADDITIONAL DATA:
Log ? Water Level Measurements Chemical Analysis Aquifer Test

REMARKS:

State Well No. 27/5-24 M₂

County Lake

Application No. _____

Water Level Record

OWNER: Bowen OWNER'S NO. #3

Description of measuring point: Top of 12" steel casing which is 4 ft. above LSD.

[illegible]

REMARKS: